


T.11S., R.2W., W.M.

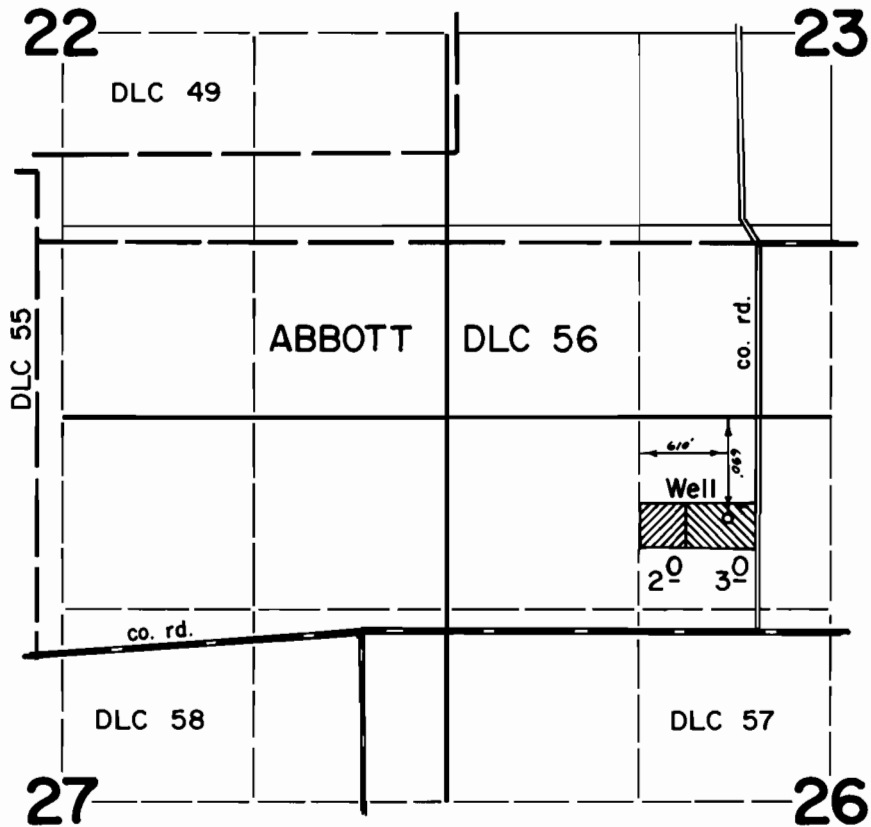

 Primary
 Supplemental

FINAL PROOF SURVEY UNDER

Application No. G-6722 Permit No. G-6259
IN NAME OF

DONALD G. CHRISTENSON

Surveyed April 16 1976, by D. Norby