


T.14S., R.1W., W.M.

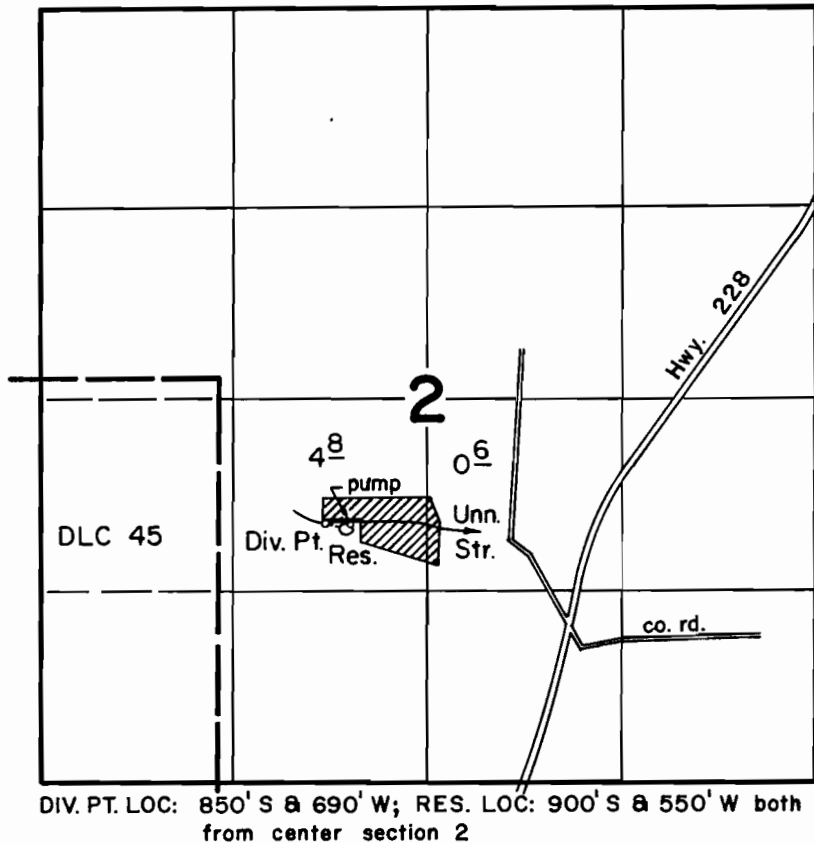

FINAL PROOF SURVEY
UNDER

Application No. R-45073 45074 Permit No. R-5323 33689
IN NAME OF

LESLIE & CAROL MALONE

Surveyed July 8 1976, by D. Norby