


T.12S., R.1E., W.M.

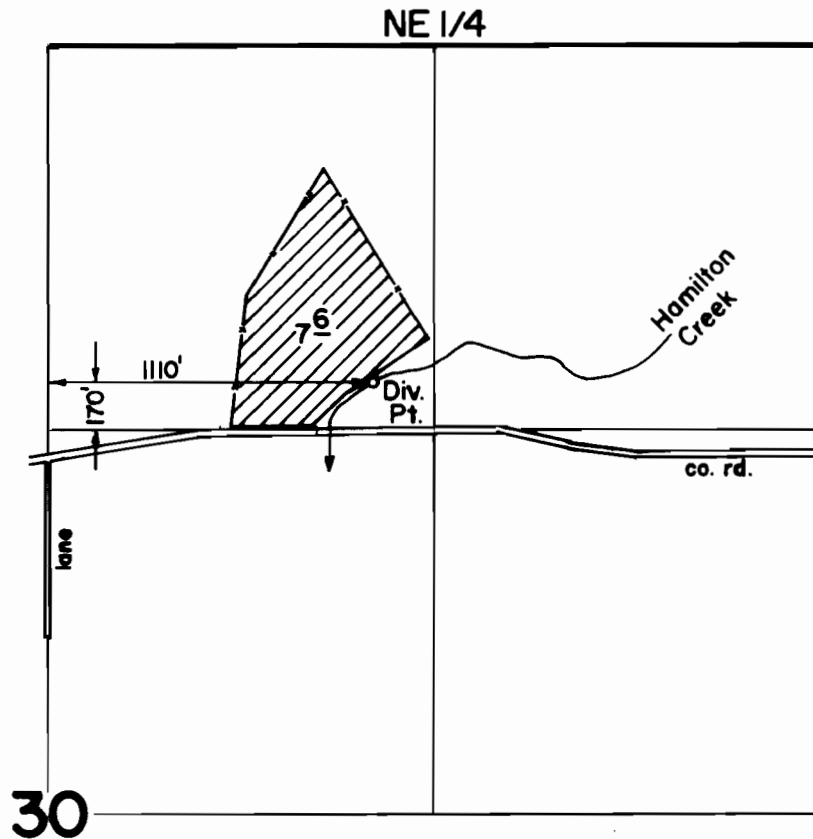

Scale: 1" = 660'

FINAL PROOF SURVEY UNDER

Application No. 48000 Permit No. 35910
IN NAME OF

WARREN M. PETERSEN

Surveyed July 6 1976, by D. Norby