


T.13S., R.2W., W.M.

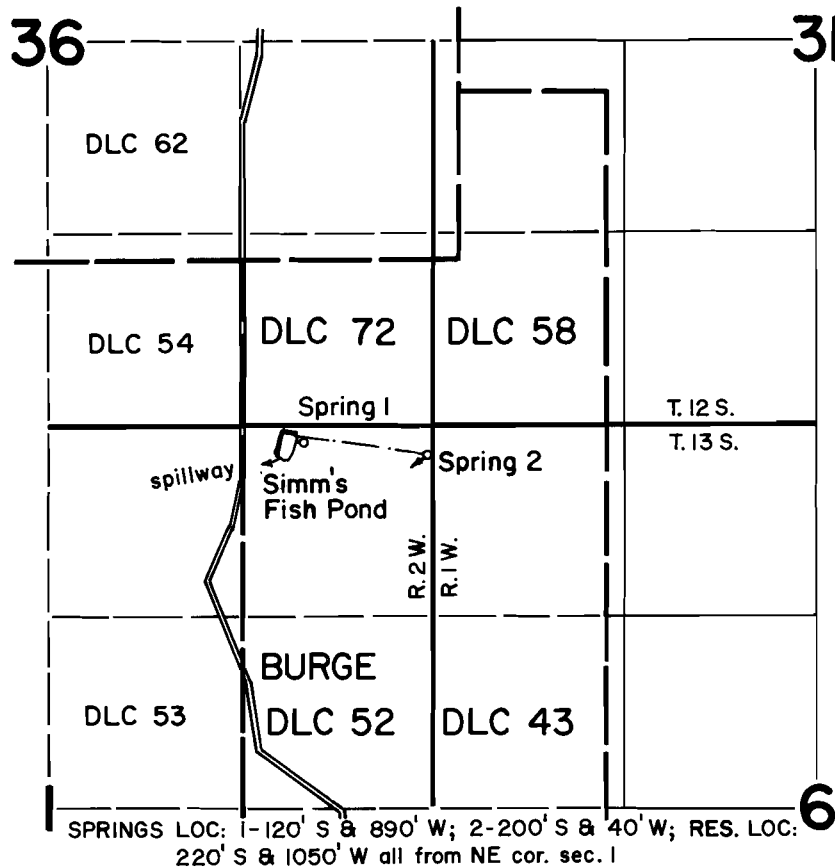

FINAL PROOF SURVEY
UNDER

R-48245 R-5865
Application No. 48246 Permit No. 36228
IN NAME OF

J. J. & VIDIS B. SIMMS

Surveyed May 6 1976, by D. Norby