


T.12S., R.1E., W.M.

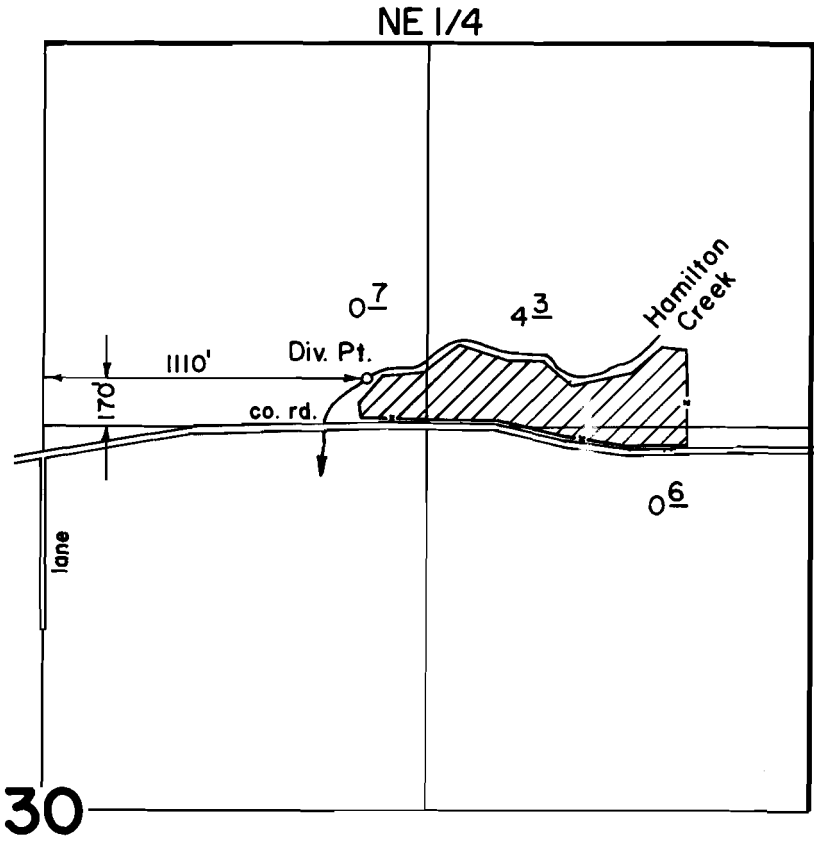

Scale: 1" = 660'

FINAL PROOF SURVEY
UNDER

Application No. 48347 Permit No. 35822
IN NAME OF

ARTHUR R. MAZAT

Surveyed July 6 1976, by D. Norby