
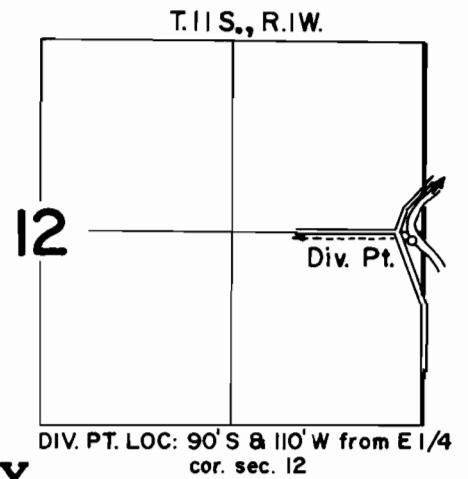


T.10&11S., R.1W., W.M.

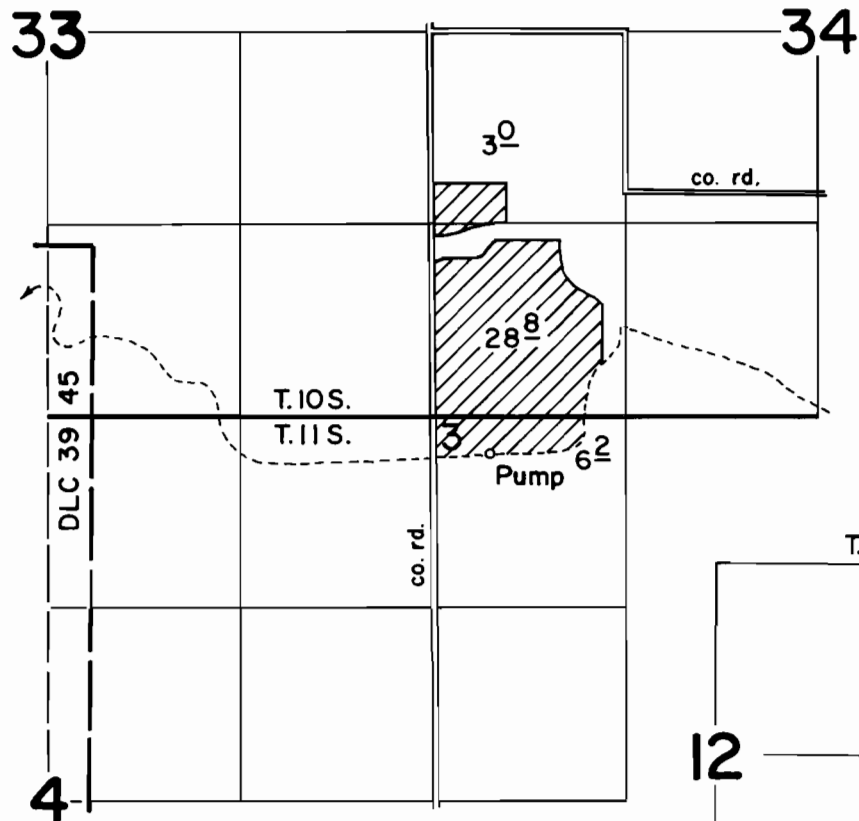

FINAL PROOF SURVEY UNDER

Application No. 48962 Permit No. 35969
IN NAME OF

CHESTER R. MOORE, JR. & DELORES J. MOORE

Surveyed Mar 30 1976, by D. Norby