


T.I.S., R.I.E., W.M.

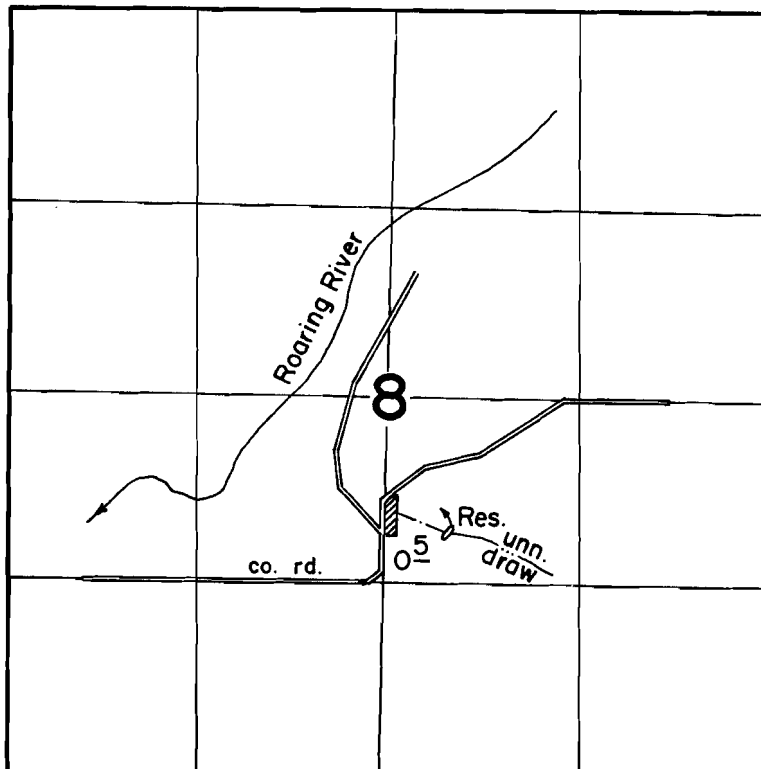

RES. LOC: 400' N & 460' E from SW cor. NW1/4 SE1/4 sec. 8

FINAL PROOF SURVEY
UNDER

R-49111 R-5979
Application No. 49112 Permit No. 36832
IN NAME OF

EDWARD & OLA HECHT

Surveyed Sept. 8, 1976, by D. Norby