


T.14S., R.1W., W.M.

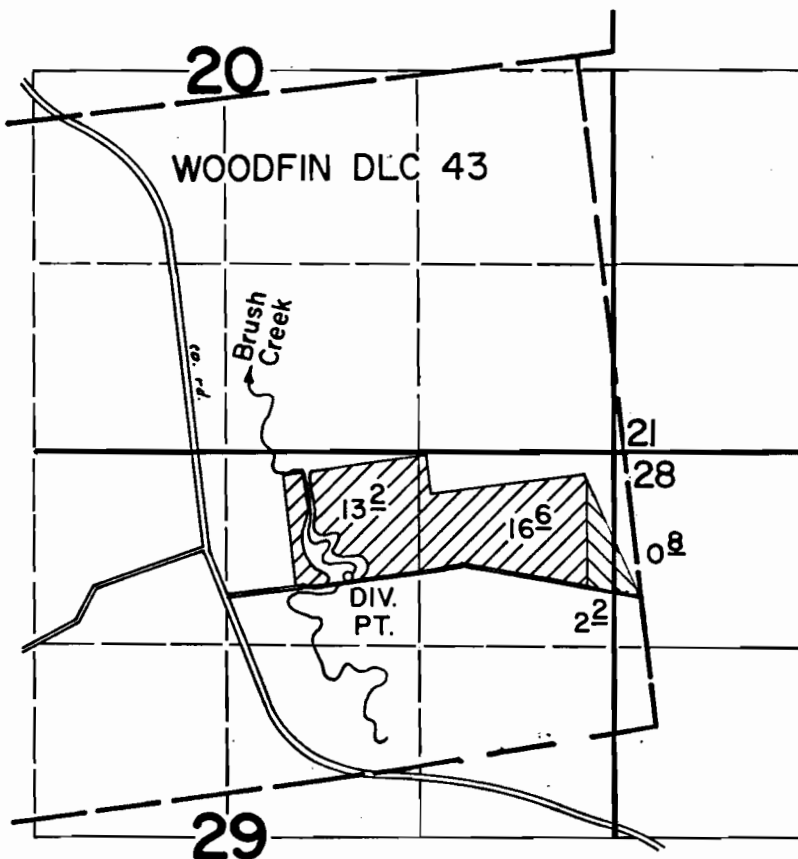

DIV. PT. LOC: 1100' N & 2120' W from SE cor. Woodpin DLC 43

FINAL PROOF SURVEY UNDER

Application No. 57900 49822 Permit No. 43643 36761
IN NAME OF



JOEY W. & PAULINE B. ACAITURRI

Surveyed May 5 1976 by D. Norby
April 22 1982 by L. M. TOLL