


T.I.S., R.I.W., W.M.

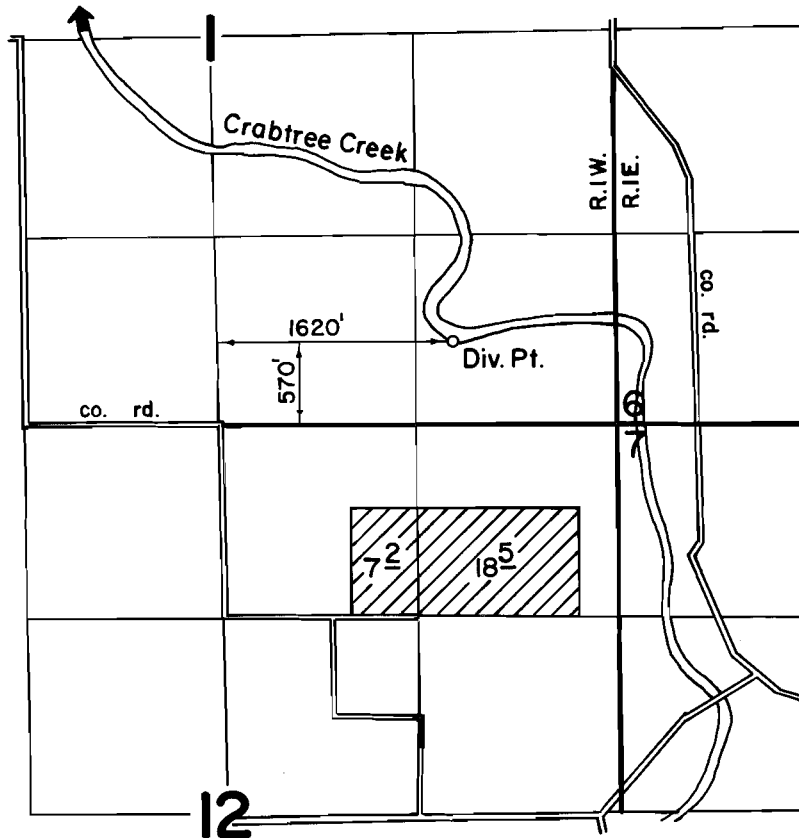

FINAL PROOF SURVEY UNDER

Application No. 50281 Permit No. 37965
IN NAME OF

PURMAN RICHEY

Surveyed Sept. 30 1976, by D. Norby