


T.10S., R.1W., W.M.

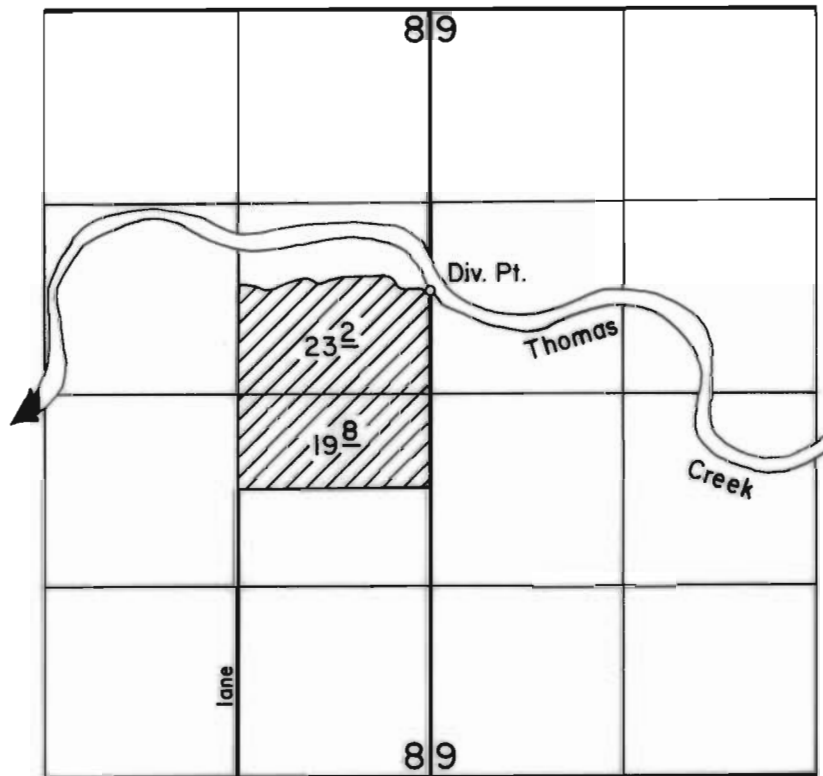

DIV. PT. LOC: 710' N from E 1/4 cor. sec. 8

FINAL PROOF SURVEY UNDER

Application No. 51762 Permit No. 39007
IN NAME OF

AUGUST V. & BETTY L. HARRIS

Surveyed Mar. 31 1976, by D. Norby