


T.12S., R.4W., W.M.

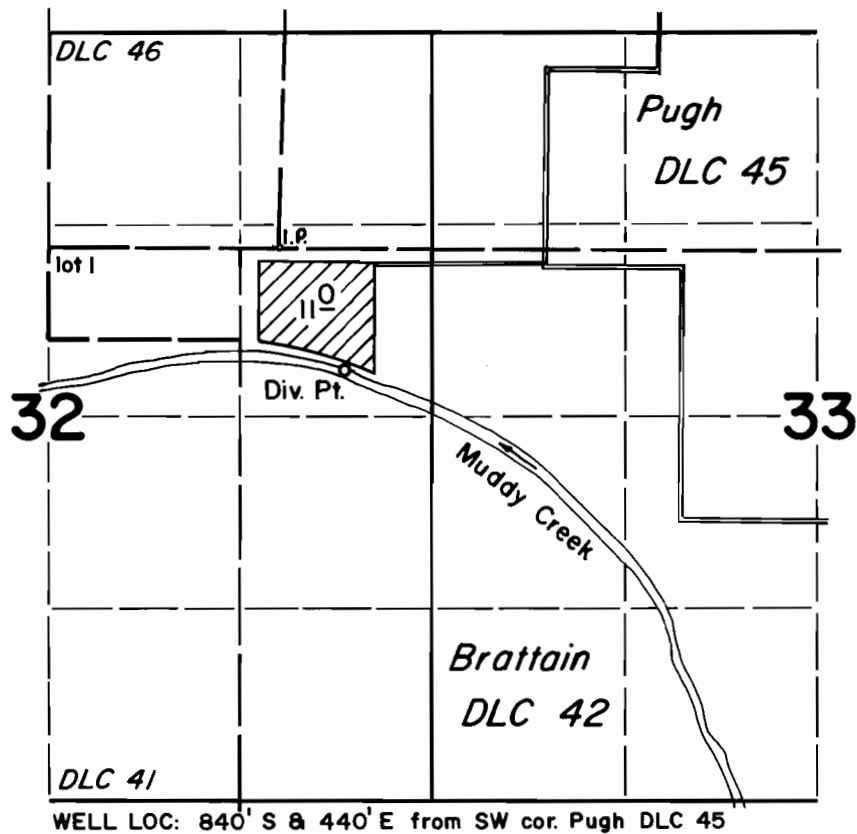

FINAL PROOF SURVEY
UNDER

Application No. 52041 Permit No. 37502
IN NAME OF

MICHAEL & VALDA DORONDO

Surveyed April 13 1976, by D. Norby