


T.9S., R.3E., W.M.

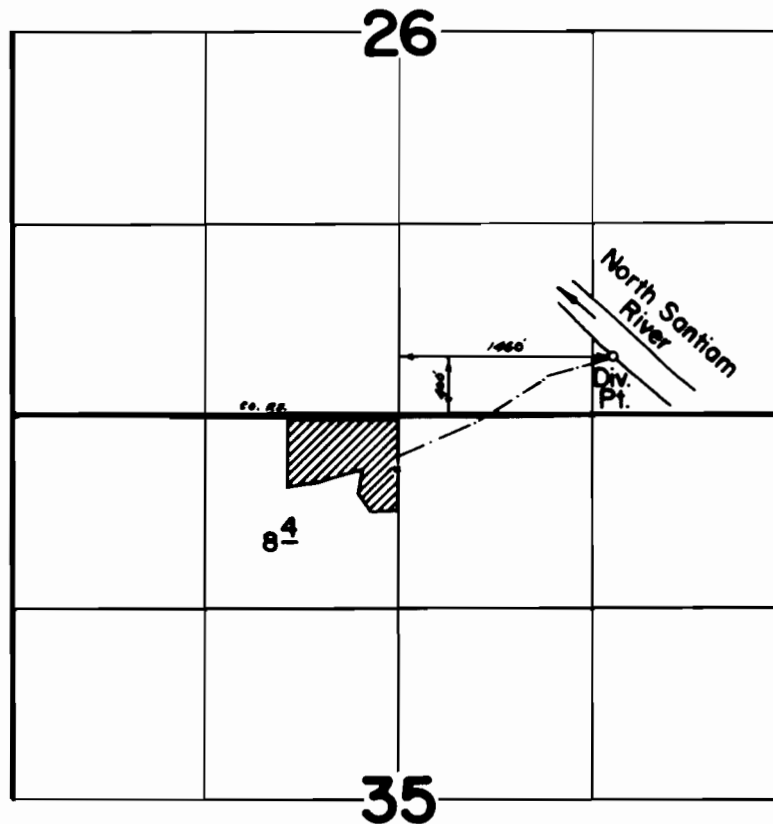

FINAL PROOF SURVEY
UNDER

Application No. 52789 Permit No. 39846
IN NAME OF

DANIEL F. PETERS

Surveyed Oct. 20 1976, by D. Norby