


T.28S. R.44E. W.M.

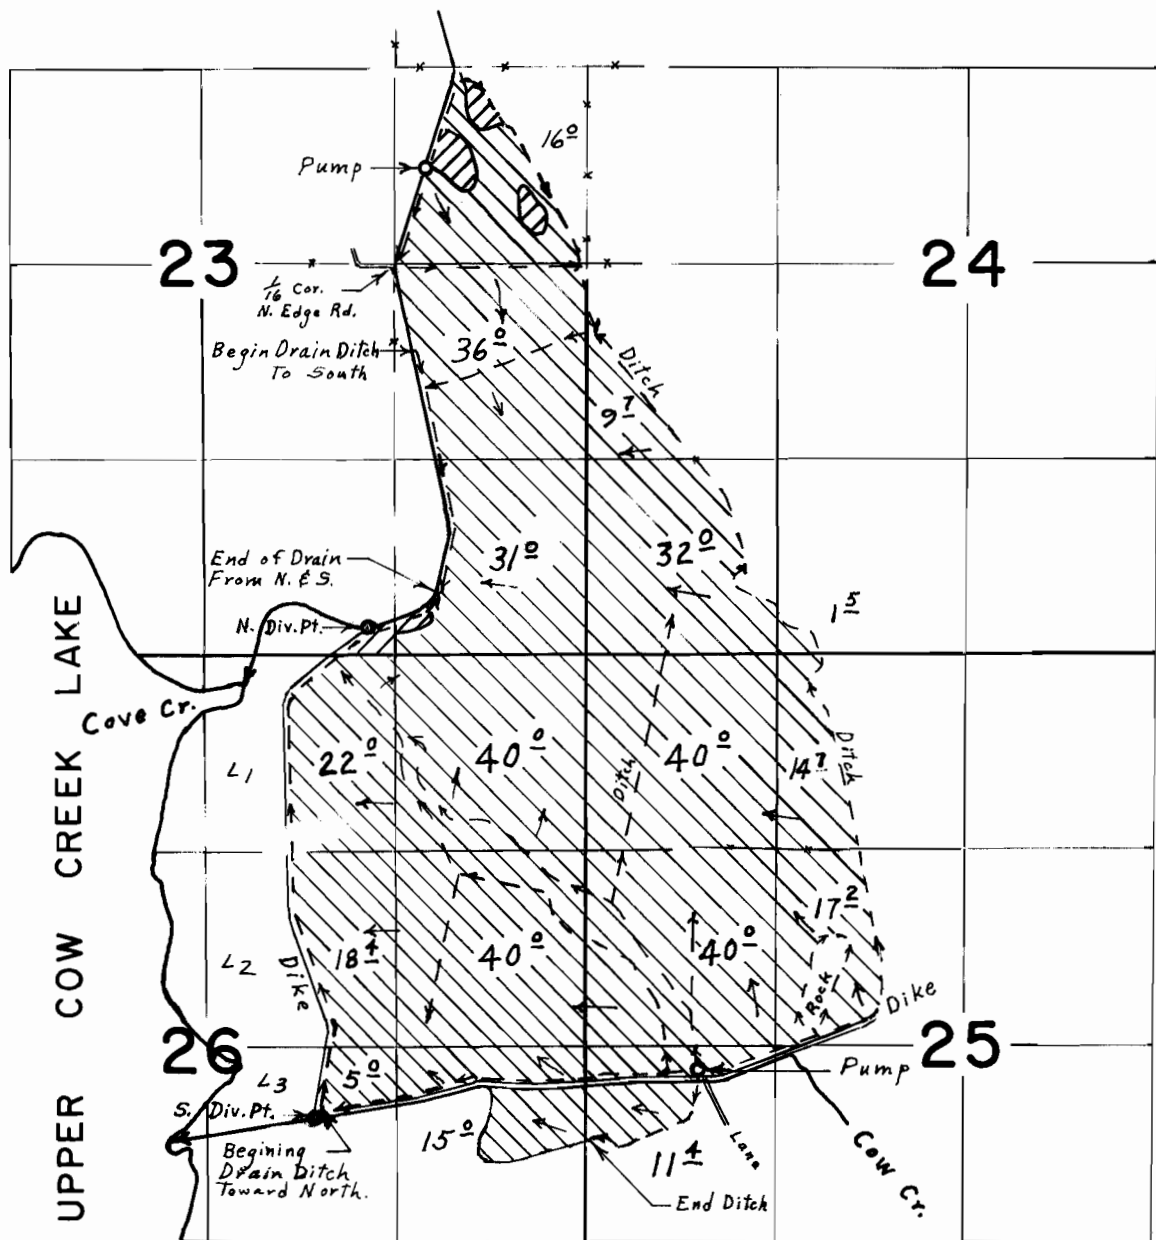

Div. Pts. located: N., 180' N. & 1500' W.; S., 3180' S. & 1870' W. both from N.E. Cor. Sec. 26

 → NO PRIMARY RIGHT
 → SUPPLEMENTAL

FINAL PROOF SURVEY UNDER

S. E. Cor. Sec. 25
F. C. →

Application No. 25861 Permit No. 28013
IN NAME OF

N. C. LODGE

Surveyed June 14, 1976, by L. E. Gould