


T.6&7 S.R.2 &3 W.W.M.

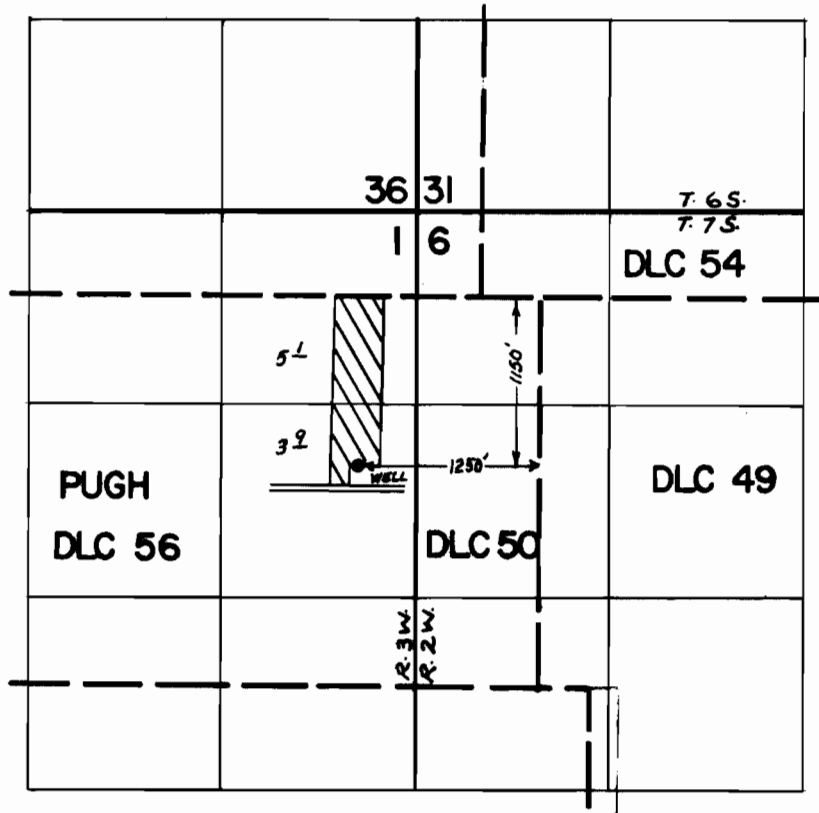

FINAL PROOF SURVEY UNDER

Application No. G-4845 Permit No. G-4563
IN NAME OF

EDWARD ZAHARA

Surveyed JUL 18 1973, by L.E GOULD
Inspection Aug 2, 1976 by R.G. Mucken