


T.6S. R.3W. W.M.

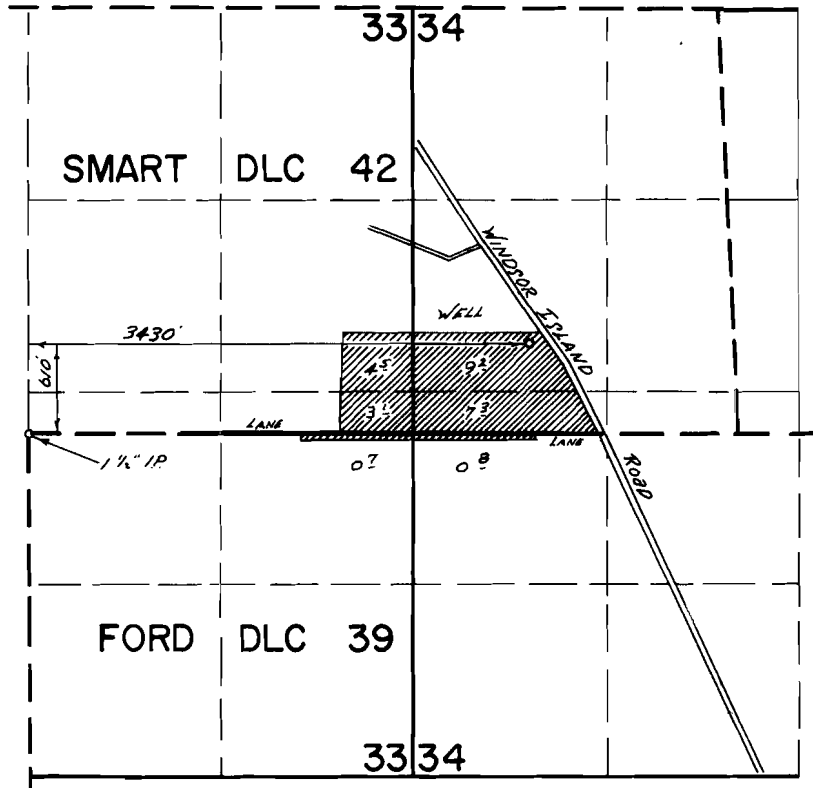

FINAL PROOF SURVEY
UNDER

Application No. G-5136.. Permit No. G-4871..
IN NAME OF

.....PHILIP J. BLAKE.....

Surveyed April 8.. 1974., by T. J. PAUL.....