


T.8S.R.3W.W.M.

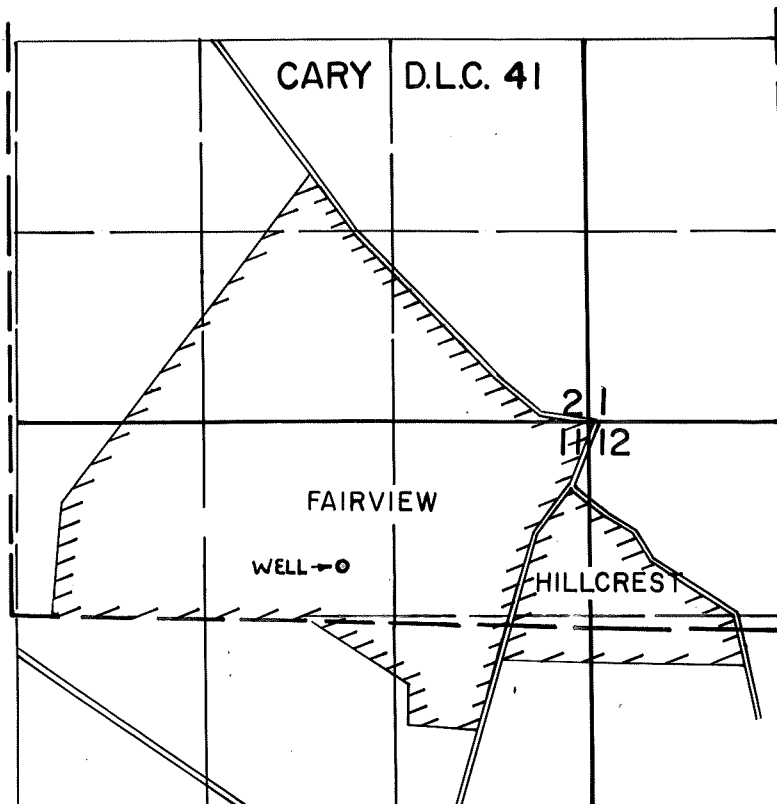

WELL LOC: 1000' S. & 1710' W. FROM N.E. COR. SEC. 11

FINAL PROOF SURVEY
UNDER

Application No. *G-5352*. Permit No. *G-5292*.
IN NAME OF

FAIRVIEW HOSPITAL & TRAINING CENTER

Surveyed *AUG. 6, 1976*, by *R. MUCKEN*.