


T.5S.,R.1W.,W.M.

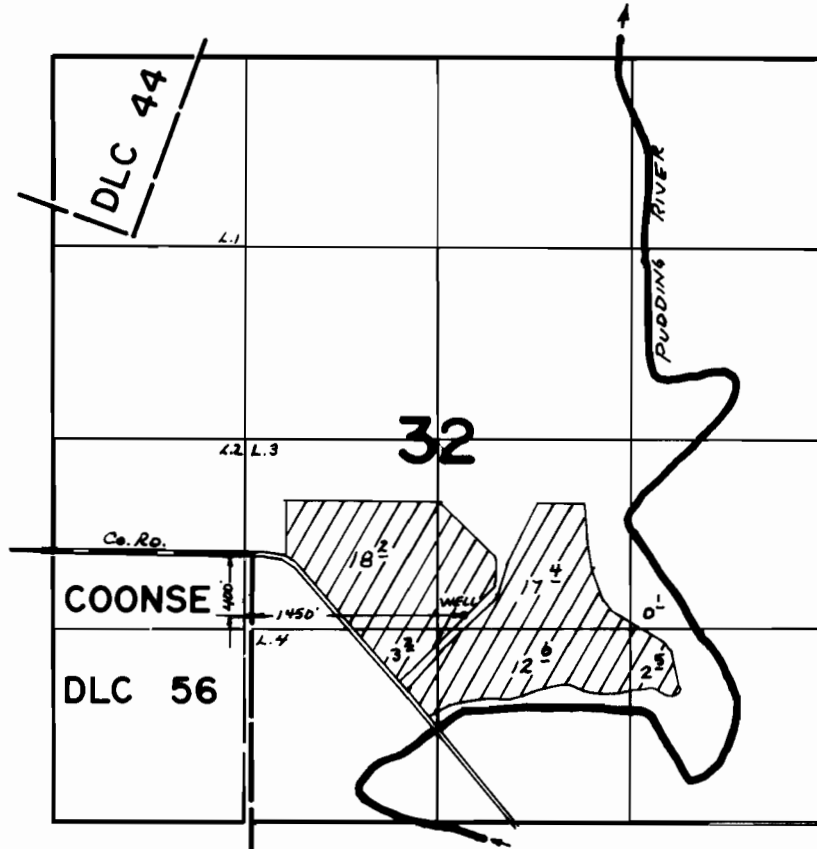

FINAL PROOF SURVEY UNDER

Application No. G-6115 Permit No. G-5789
IN NAME OF

RUDY R. WALTERS

Surveyed APRIL 21, 1976, by L. TOLL