


T.6S.,R.2W.,W.M.

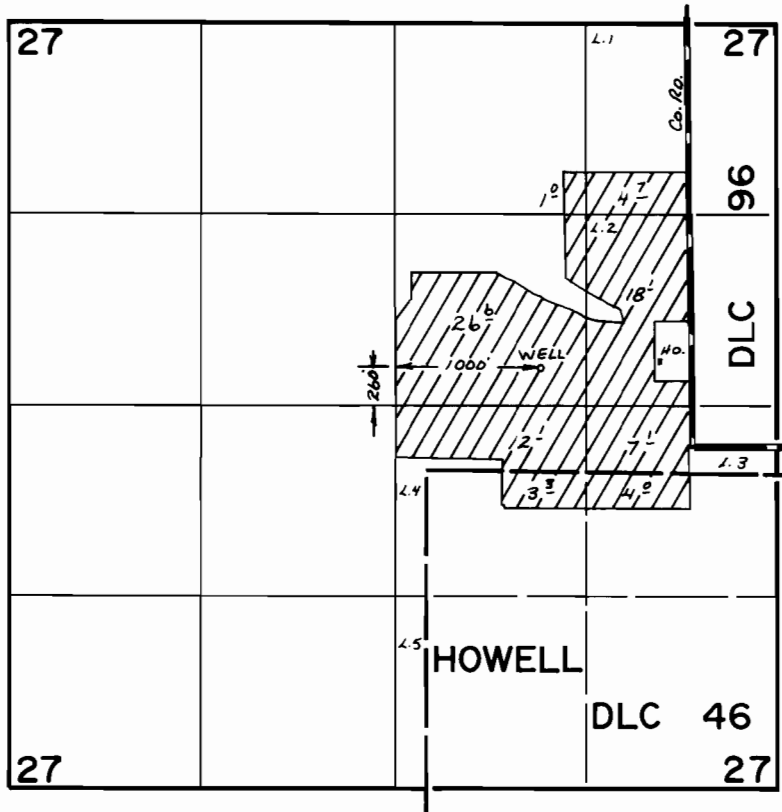

FINAL PROOF SURVEY UNDER

Application No. G-6301. Permit No. G-5923.
IN NAME OF

RAYMOND A. HASLEBACHER

Surveyed May 7, 1976, by L. Tou.