


T.6S.,R.2W.,W.M

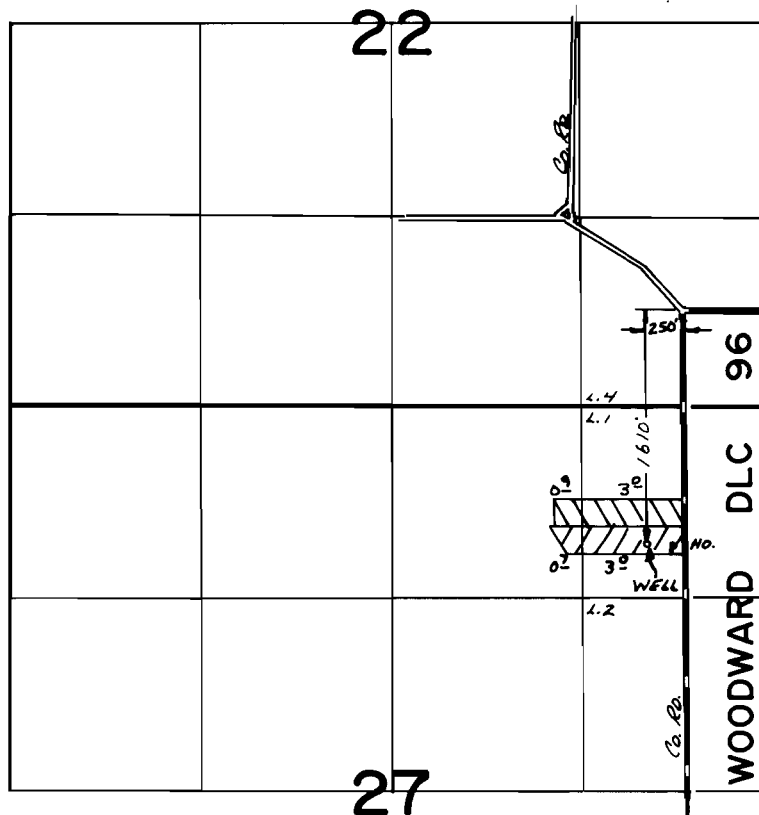

FINAL PROOF SURVEY
UNDER

Application No. G-6513 Permit No. G-6125 
G-7273 G-6709
IN NAME OF

DANIEL E. & CYNTHIA PALMER

Surveyed *May 7* 197*6*, by *L. Toll*