


# T.6S.,R.2W.,W.M.

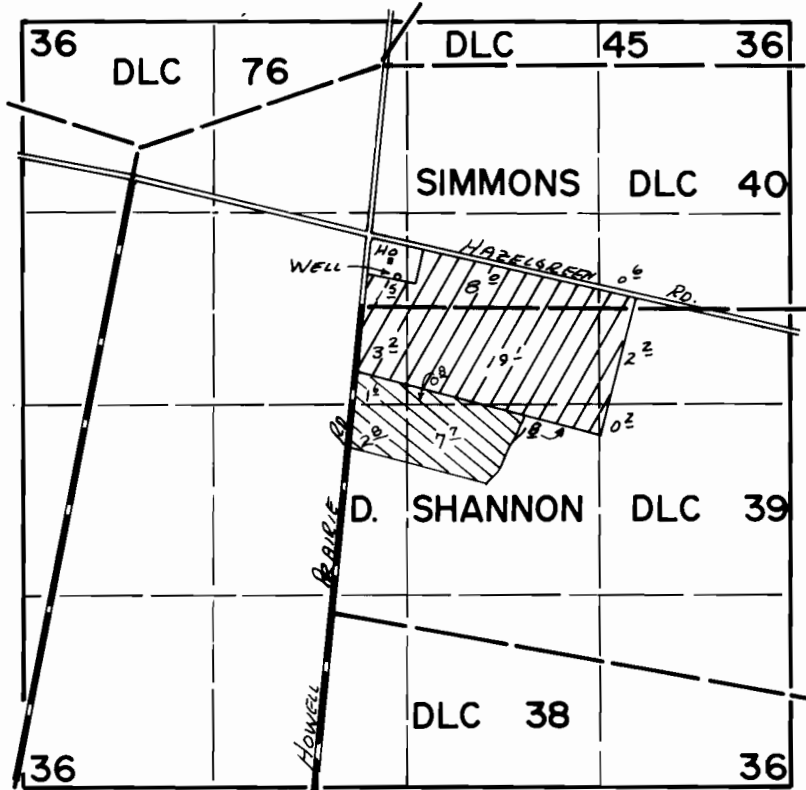


WELL LOC: 200' N AND 250' E FROM NW COR. D. SHANNON DLC 39

Scale: 1" = 1320'

## FINAL PROOF SURVEY UNDER

G-10286                      G-9393  
Application No. G-6547. Permit No. G-6152...  
IN NAME OF

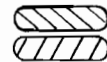

.....ROBERT H. HARI.....

Surveyed MAY 7, 1976, by L. TOLL.....  
MAY 30, 1984; BEN BISHOP