


T.6S.,R.2W.,W.M

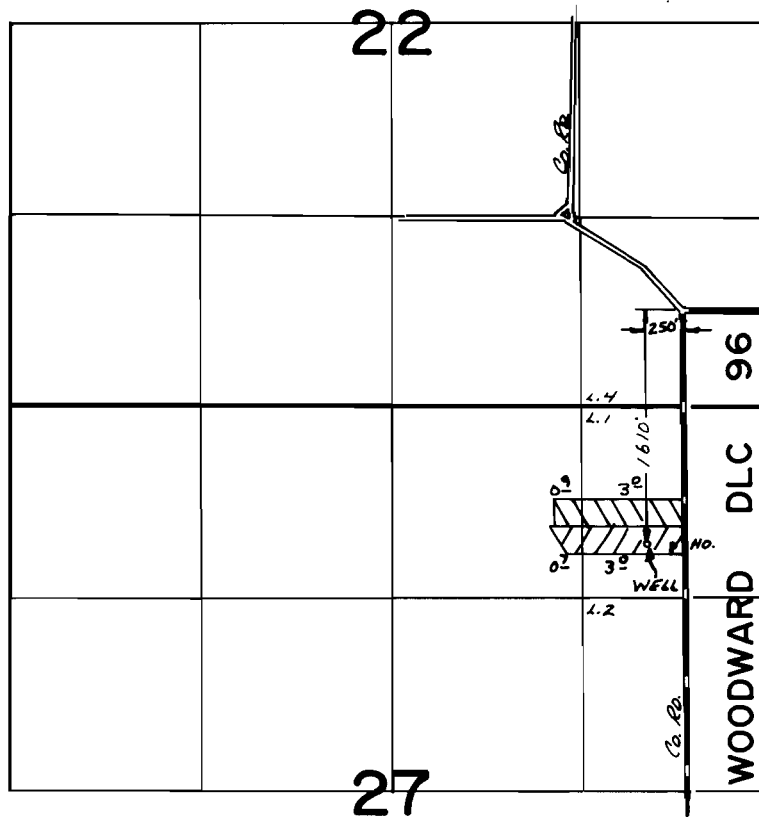

FINAL PROOF SURVEY
UNDER

Application No. G-6513 G-6125
G-7273 Permit No. G-6709 
IN NAME OF

DANIEL E. & CYNTHIA PALMER

Surveyed *May 7* 1976, by *L. Toll*