


T.9S.,R.1E.,W.M.

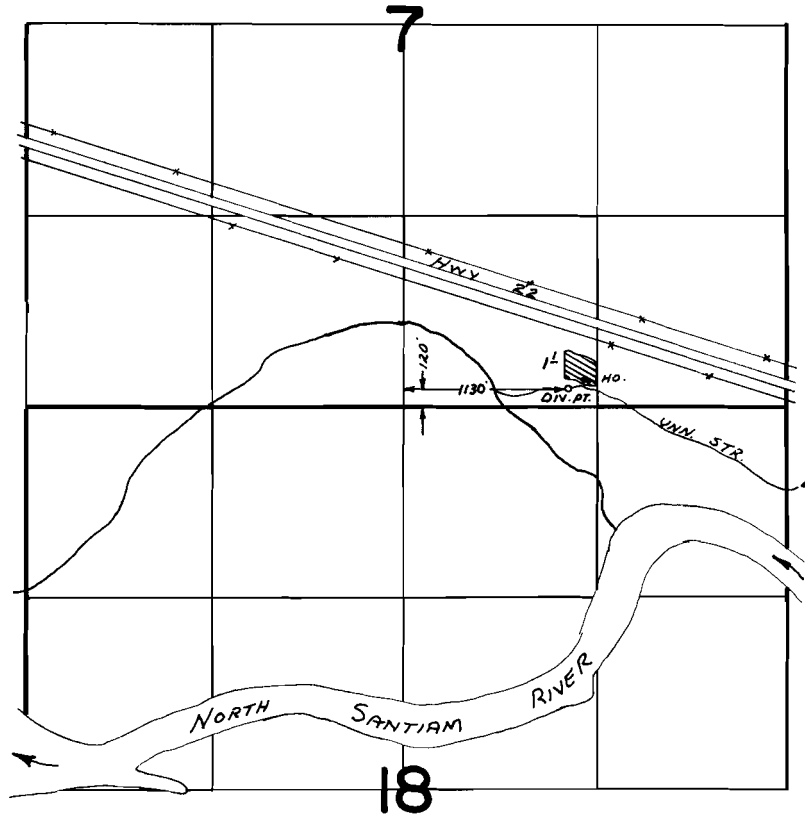

FINAL PROOF SURVEY
UNDER

Application No. 50467 Permit No. 38216...
IN NAME OF

LEWIS B. LETSON

Surveyed July 7, 1976, by J. T. Tom