


T.6S.,R.3W.,W.M.

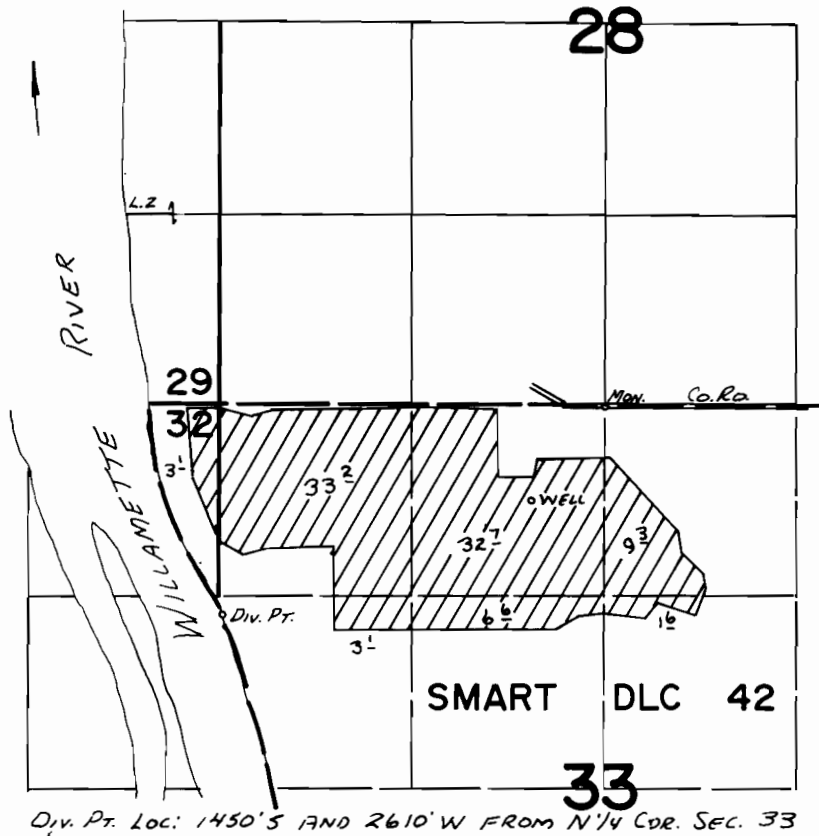

FINAL PROOF SURVEY
UNDER

Application No. 52940 Permit No. 39969
IN NAME OF

CHAUNCY W. LEEVE

Surveyed OCT. 4, 1976, by L. TALL