


# T.7S.,R.1W.,W.M.

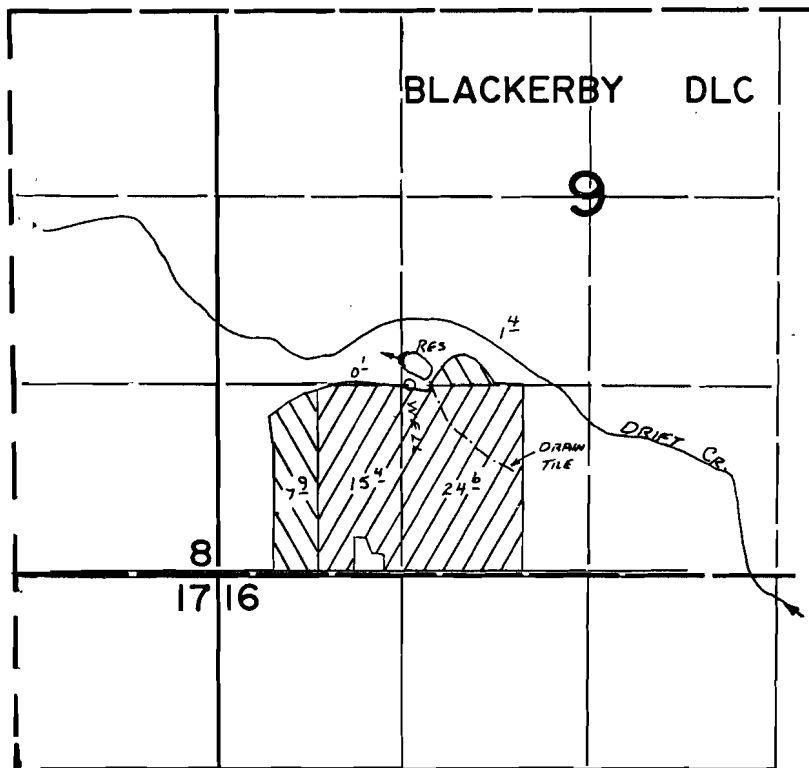

DIV LOC: 1480' N AND 2620' E FROM SW COR. BLACKERBY D.L.C.  
 WELL LOC. 1320' N & 2700' E FROM SW COR. BLACKERBY D.L.C.

## FINAL PROOF SURVEY UNDER

G-7146                      G-6698  
 R-53731                     R-6391  
 Application No. 53732.. Permit No. 39930..  
 IN NAME OF

ERNEST A. KLOPFENSTEIN

Surveyed Aug. 26, 1976, by D.M. NORBY..  
 INSPECTED APR. 12, 1977, BY L.H. NUNN