


T.7S.,R.1W.,W.M.

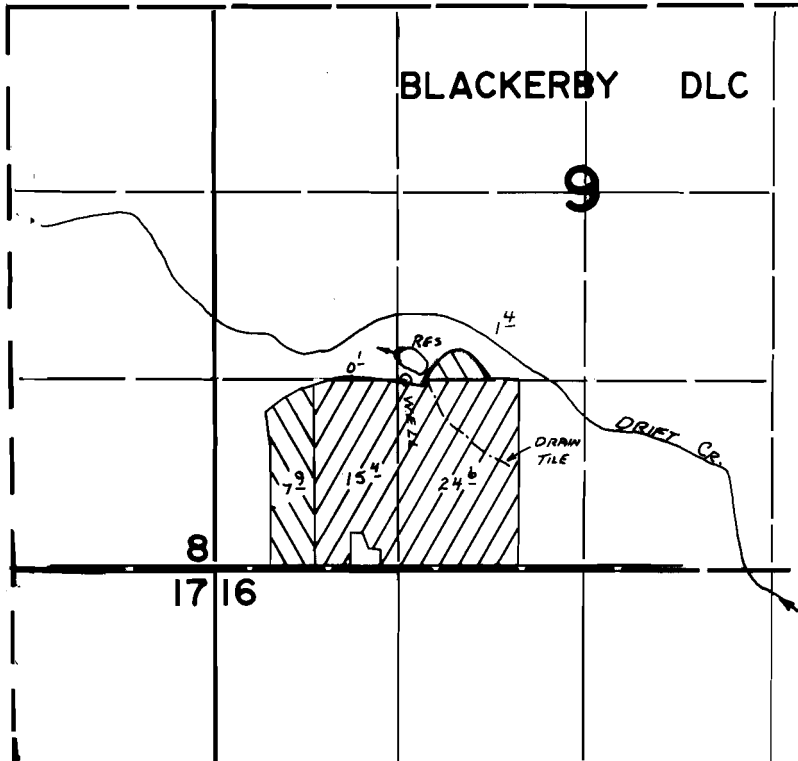

DIV LOC: 1480' N AND 2620' E FROM SW COR. BLACKERBY D.L.C.
WELL LOC. 1320' N & 2700' E FROM SW COR. BLACKERBY D.L.C.

FINAL PROOF SURVEY UNDER

G-7146

G-6698

R-53731

R-6391

Application No. 53732 Permit No. 39930
IN NAME OF

ERNEST A. KLOPFENSTEIN

Surveyed Aug. 26, 1976, by D. M. NORBY
INSPECTED APR. 12, 1977, BY L. H. NUAIN