T. IN. R. I E. W. M.

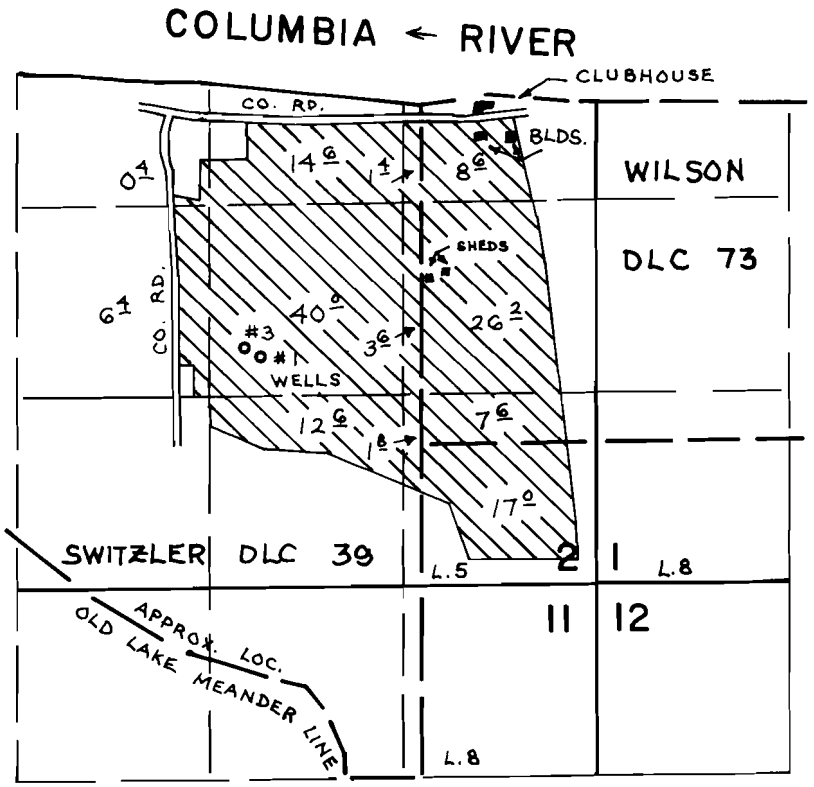

WELL # 1 LOC. - 620'N. & 1090'W. & WELL # 3 LOC. - 680'N. & 1210'W. BOTH FROM S.W. COR. SARAH WILSON D.L.C. 73

FINAL PROOF SURVEY
UNDER

Application No. G-5614 Permit No. G-5153
IN NAME OF
COLUMBIA - EDGEWATER COUNTRY CLUB

Surveyed July 8 1976, by R. G. Mucken

DHM
DFO-2LL-198