


# T.6S., R.6W., W.M.

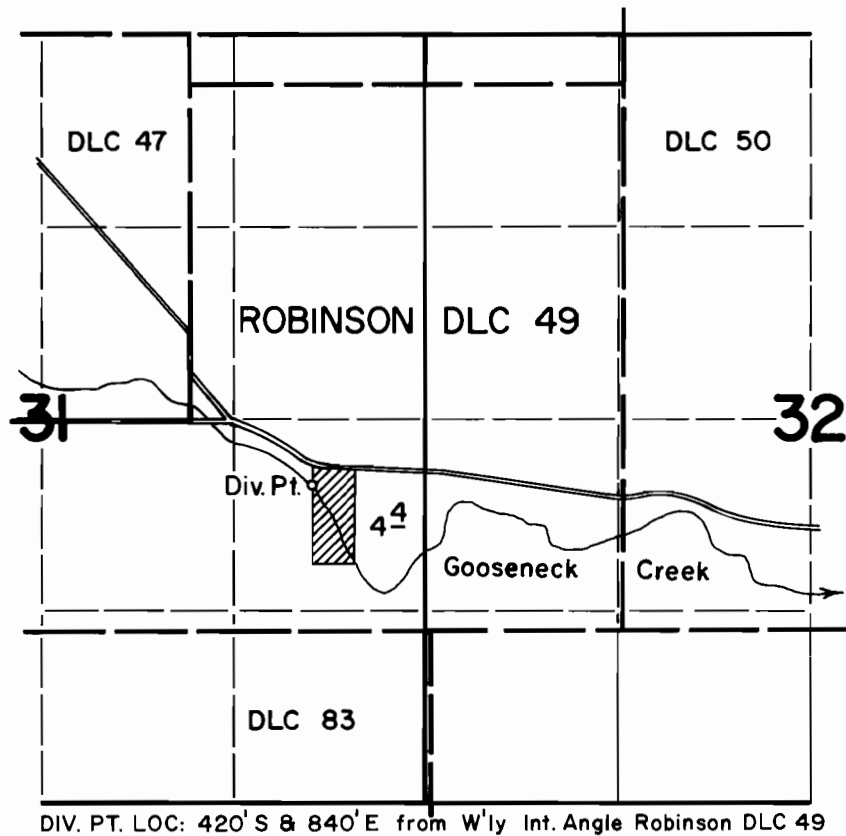

## FINAL PROOF SURVEY UNDER

Application No. 51512 Permit No. 38875  
IN NAME OF

ROBERT J. BAUER

Surveyed Oct. 22, 1976, by D. Norby