


T.6S., R.5W., W.M.

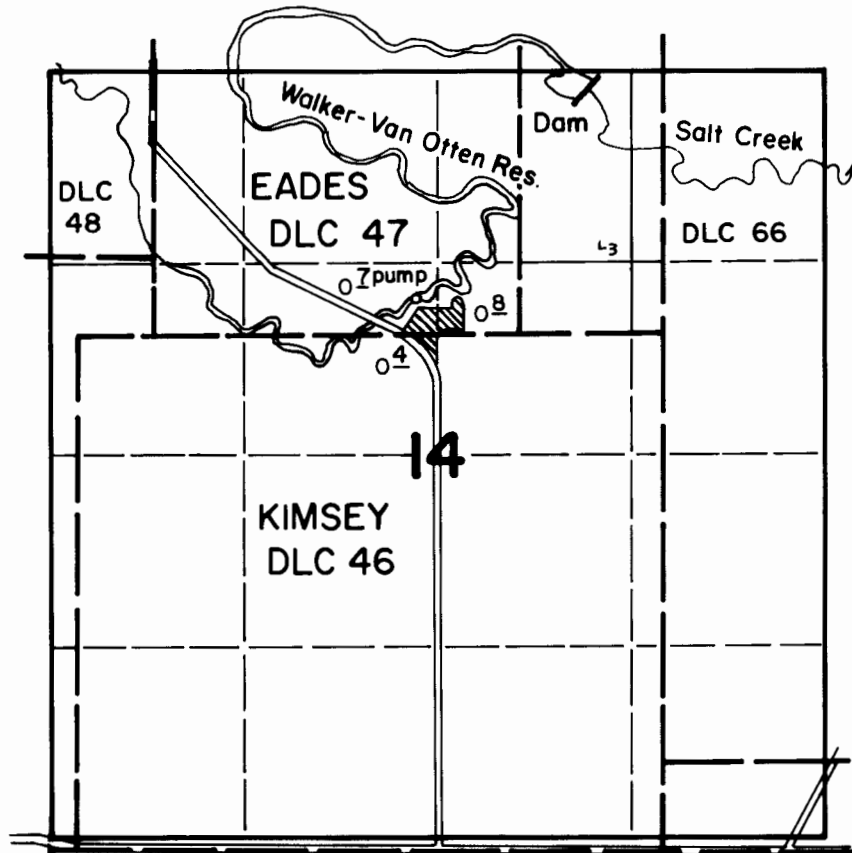

DIV. PTS. LOC: Dam-150' S & 3600' E; Pump-1570' S & 2500' E
both from NW cor. sec. 14

FINAL PROOF SURVEY
UNDER

Application No. 52998 Permit No. 40005
IN NAME OF
DAN VAN OTTEN

Surveyed Oct. 22 1976, by D. Norby