


T.3S., R.9W., W.M.

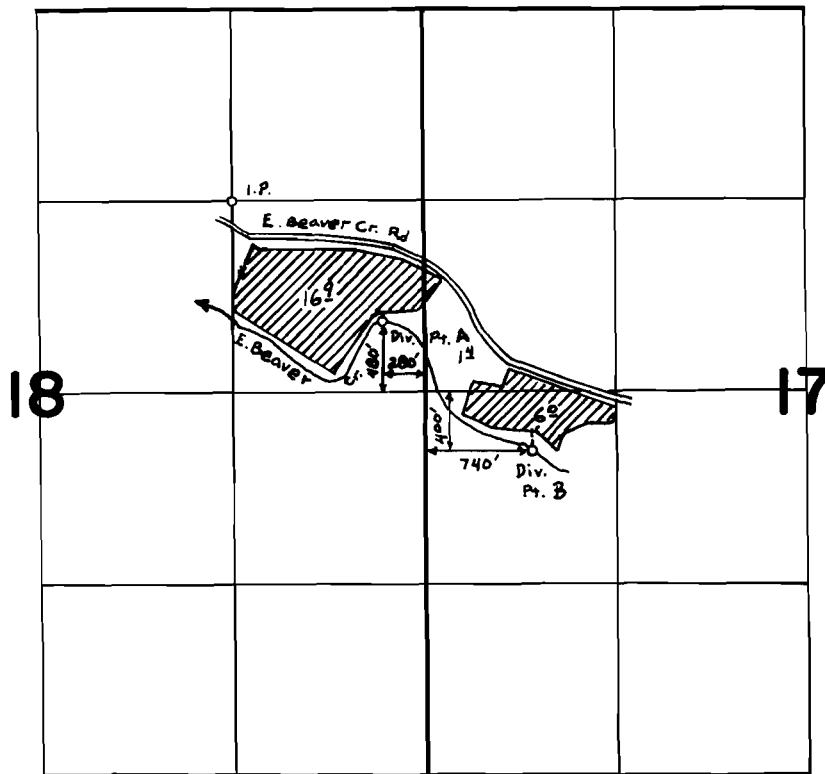

FINAL PROOF SURVEY
UNDER

Application No. 45500 Permit No. 33958
IN NAME OF

RUSSELL L. & OLIVE M. HAMLIN

Surveyed JUNE 25 1976, by D. NORBY