


T.4S., R.9W., W.M.

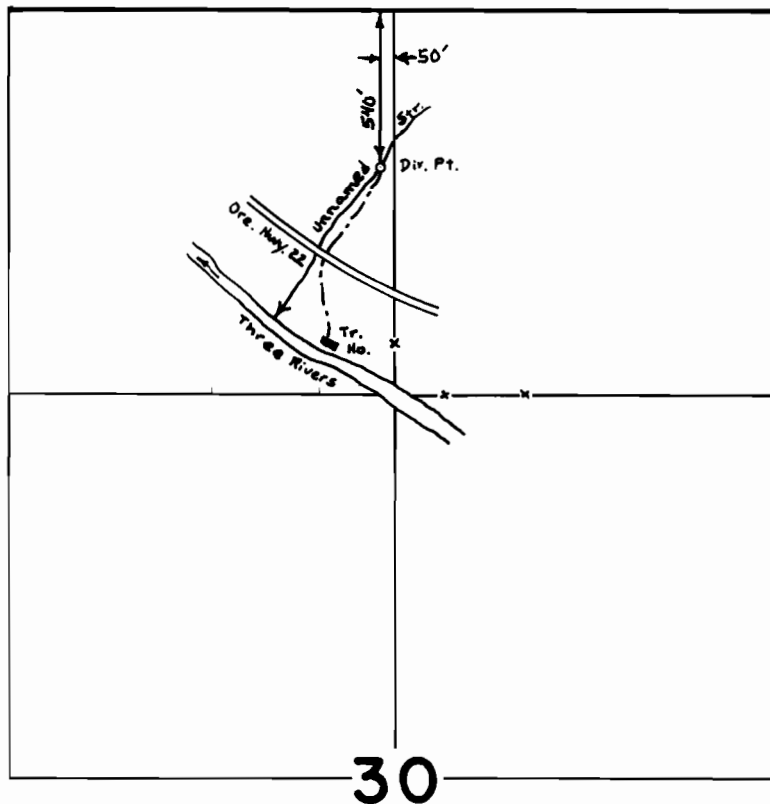

SCALE: 1" = 660'

FINAL PROOF SURVEY UNDER

Application No. 49016 Permit No. 36044
IN NAME OF

KEITH L. SNYDER

Surveyed JUNE 22 1976, by D. NORBY