


# T.4S., R.9-10W., W.M.

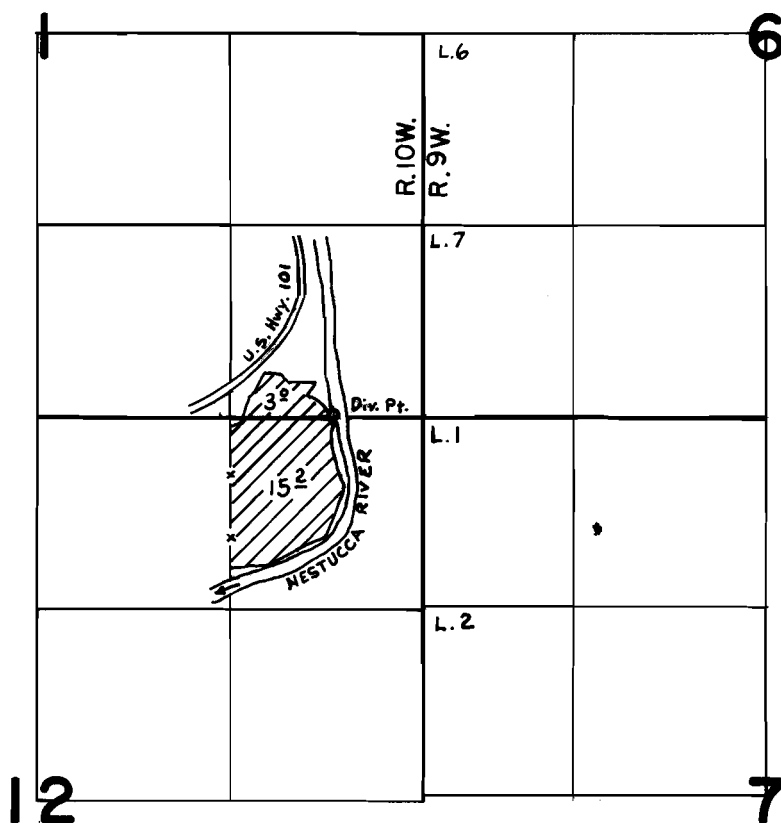

Div. Pt. Located: 10' N., 600' W. from the SE. cor. Sec. 1

## FINAL PROOF SURVEY UNDER

Application No. 50187 Permit No. 37692  
IN NAME OF

LEROY L. LAUNDERS

Surveyed JUNE 23 1976, by D. NORBY