


T. 4S., R. 10W., W.M.

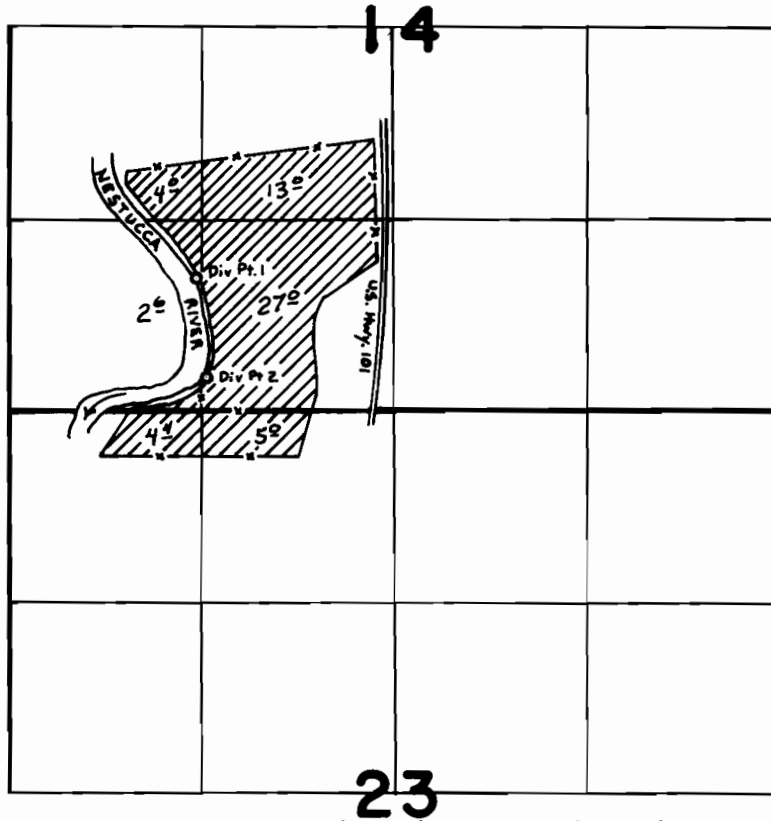

Div. Pts. Located: 1- 900' N, 40' W.; 2- 220' N, 20' E from
S.W. cor. of SE $\frac{1}{4}$ SW $\frac{1}{4}$ Sec. 14

FINAL PROOF SURVEY UNDER

Application No. 51075 Permit No. 38538
IN NAME OF

EMIL TOEDTLI

Surveyed JUNE 22 1976, by D. NORBY