


T. 4 S., R. 10 W., W.M.

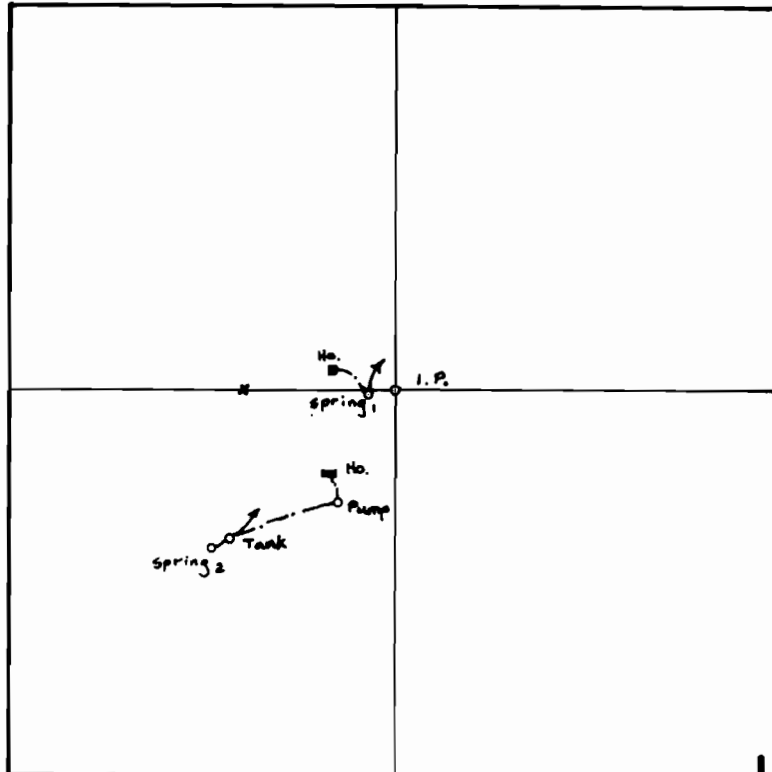

13

Springs Located: 1-10' S., 90' W.; 2-540' S., 630' W.
from the N.E. cor. of the SW $\frac{1}{4}$ NW $\frac{1}{4}$

SCALE: 1" = 660'

FINAL PROOF SURVEY UNDER

51236 37422
Application No. TR-2900 Permit No.
IN NAME OF

LEONARD WHITMORE

Surveyed JUNE 22, 1976, by D. NORBY