


T.4S., R.10W., W.M.

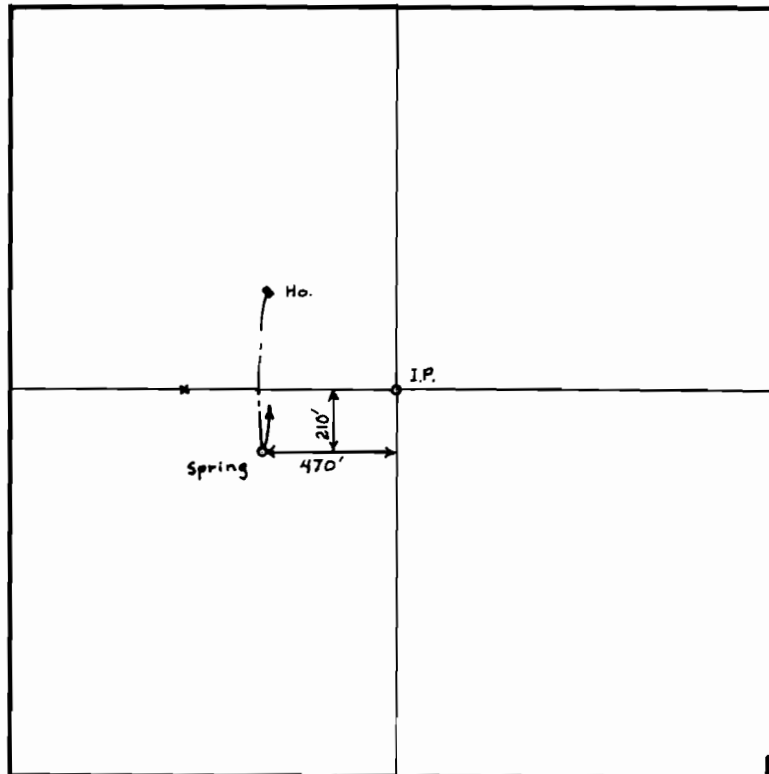

13

SCALE: 1" = 660'

FINAL PROOF SURVEY
UNDER

Application No. 52418 Permit No. 39428
IN NAME OF

GOLDY P. PETERSON

Surveyed JUNE 22 1976, by D. NORBY