


T5N R.29E. WM

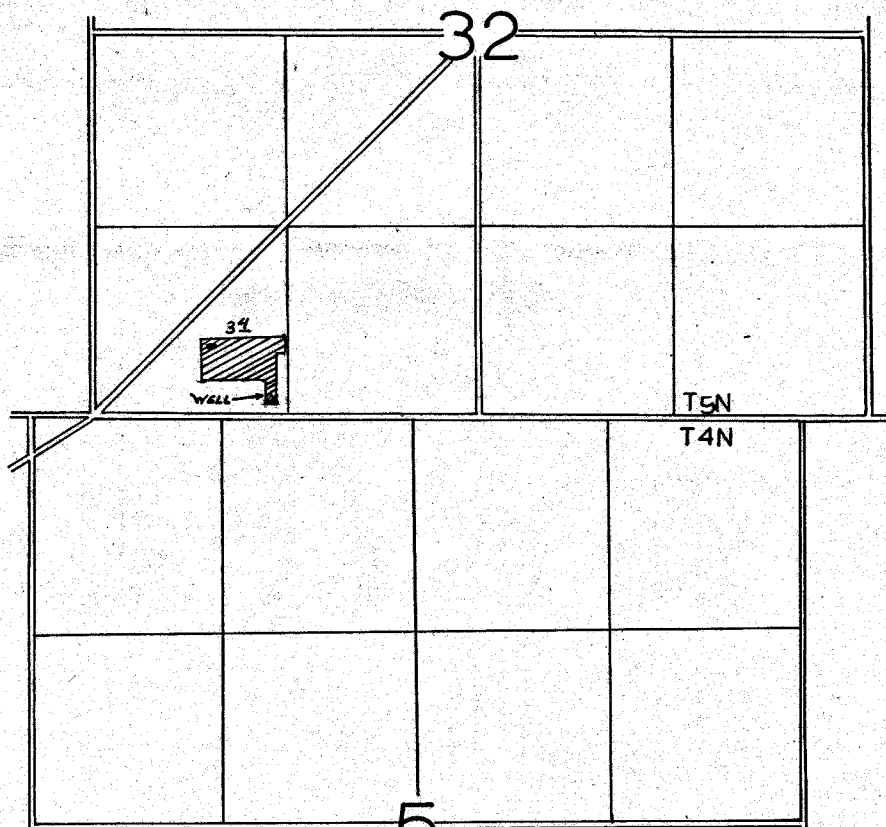

WELL LOCATED 150' N & 1220' E FROM SW COR
SEC 32

FINAL PROOF SURVEY
UNDER

Application No. G-5231. Permit No. G-5089
IN NAME OF

GLEN E. & MARION L. MALE

Surveyed FEB. 16, 1978, by R. BARWIN