


G-5947
46509

T.4N. R.29E. W.M.

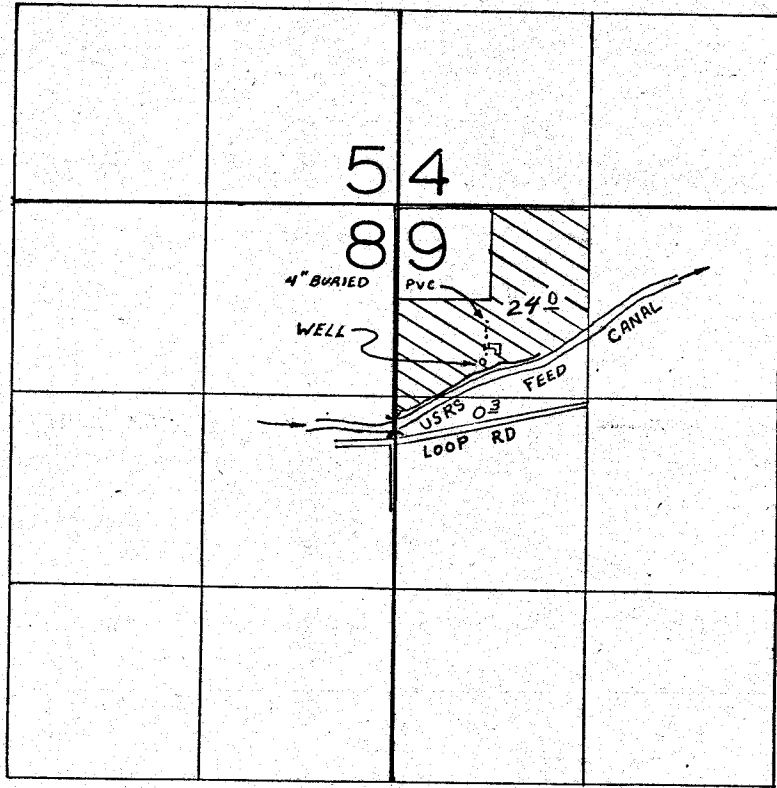

WELL LOCATED 1050'S & 600'E FROM NW COR
SEC 9

FINAL PROOF SURVEY
UNDER

Application No. G-6344 Permit No. G-5947
IN NAME OF

.....WILLIAM A. KOPACZ.....

Surveyed FEB. 16.... 1978., by B. BARWIN.....