


T. 4N. R. 37E. W.M.

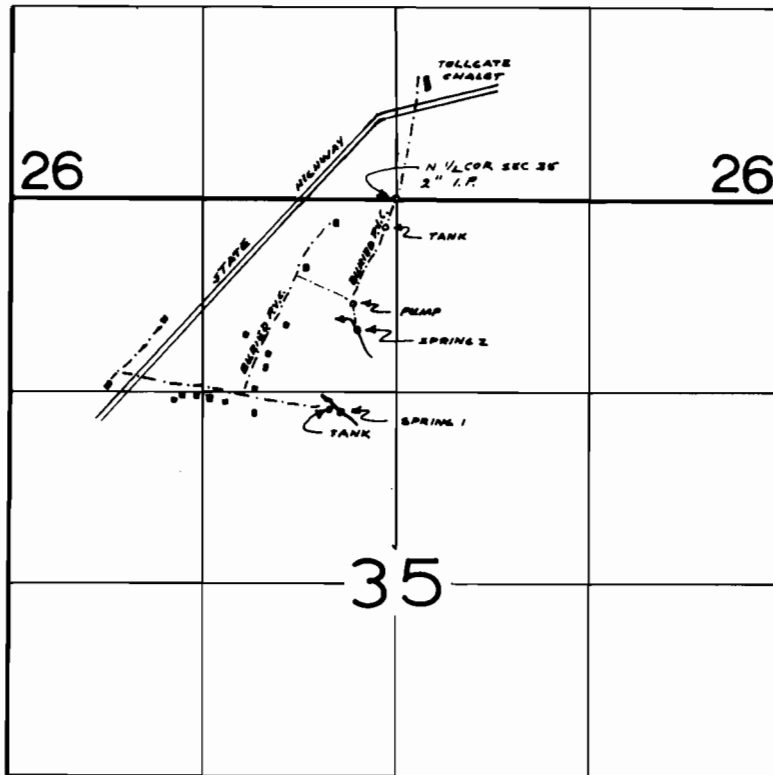

SPRING 1 LOCATED 380' W & 1450' S FROM N 1/4 COR SEC 35
SPRING 2 LOCATED 270' W & 370' S FROM N 1/4 COR SEC 35

FINAL PROOF SURVEY
UNDER

Application No. 55180 Permit No. 41606
IN NAME OF

BLUE MOUNTAIN CAMP, INC.

Surveyed OCT. 14, 1977, by R. BARWIN