


# T. 2 S., R. 38 E., W.M.

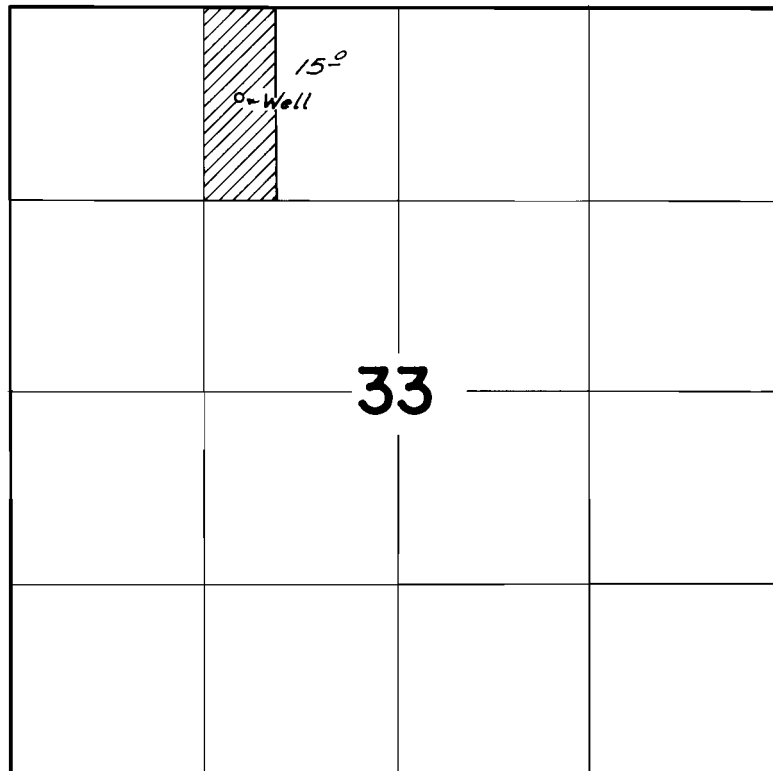

Well Loc.: 620' S. of 1570' E. from NW Cor. Sec 33

## FINAL PROOF SURVEY UNDER

Application No. G-5249 Permit No. G-5103  
IN NAME OF

Donald R. Conner

Surveyed Sept. 27, 1976 by D. M. Norby