


T.3 S., R.39 E., W.M.

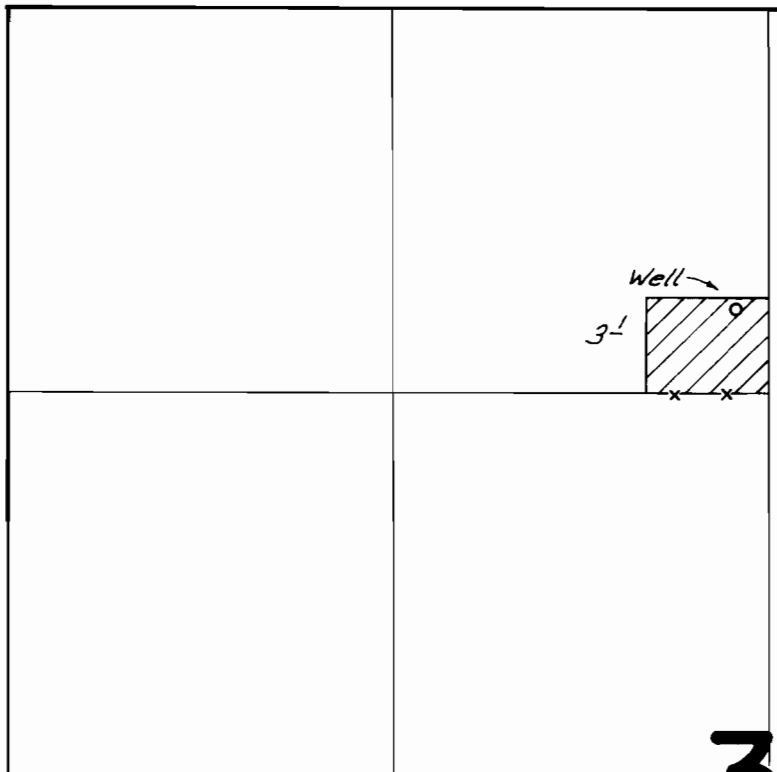

Well Loc.: 290' N. & 150' W. from SE Cor.  
NE<sup>4</sup>NW<sup>4</sup> Sec 34

34

SCALE 1" = 660'

**FINAL PROOF SURVEY**  
UNDER

Application No. G-6577 Permit No. G-6171  
IN NAME OF

Sherman E. & M. Hazel Hawkins

Surveyed Sept 24, 1976 by D. M. Norby

PTS-1976-C *DNB*