


T.3S., R.39E., W.M.

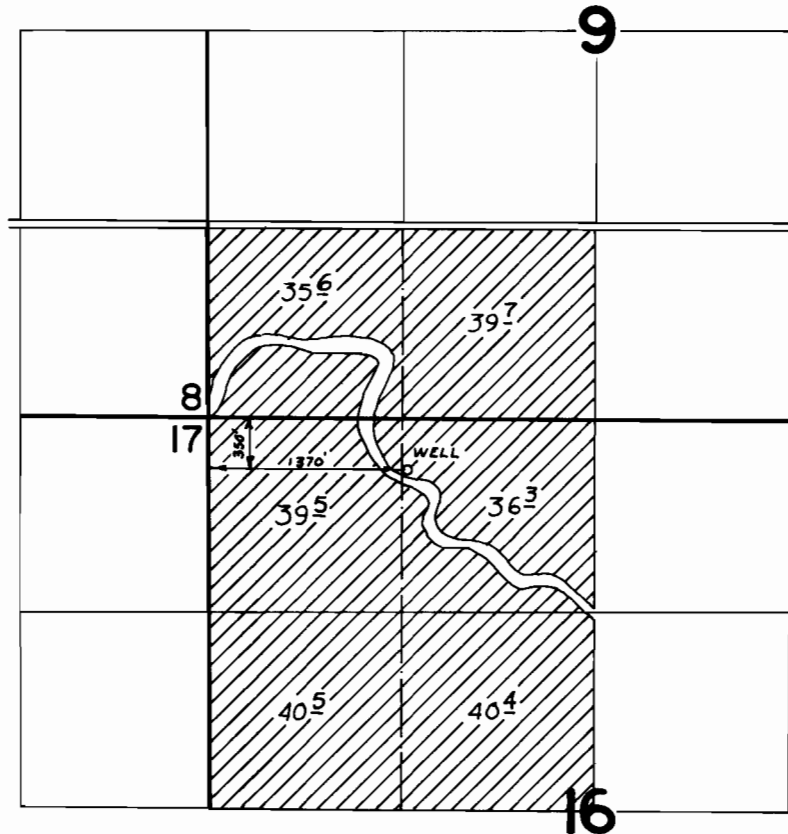

FINAL PROOF SURVEY
UNDER

Application No. G-6750 Permit No. G-6272
IN NAME OF

ROBERT & SHARON BECK

Surveyed Sept. 27 1976, by D. Norby