


T. 3 S., R. 40 E., W.M.

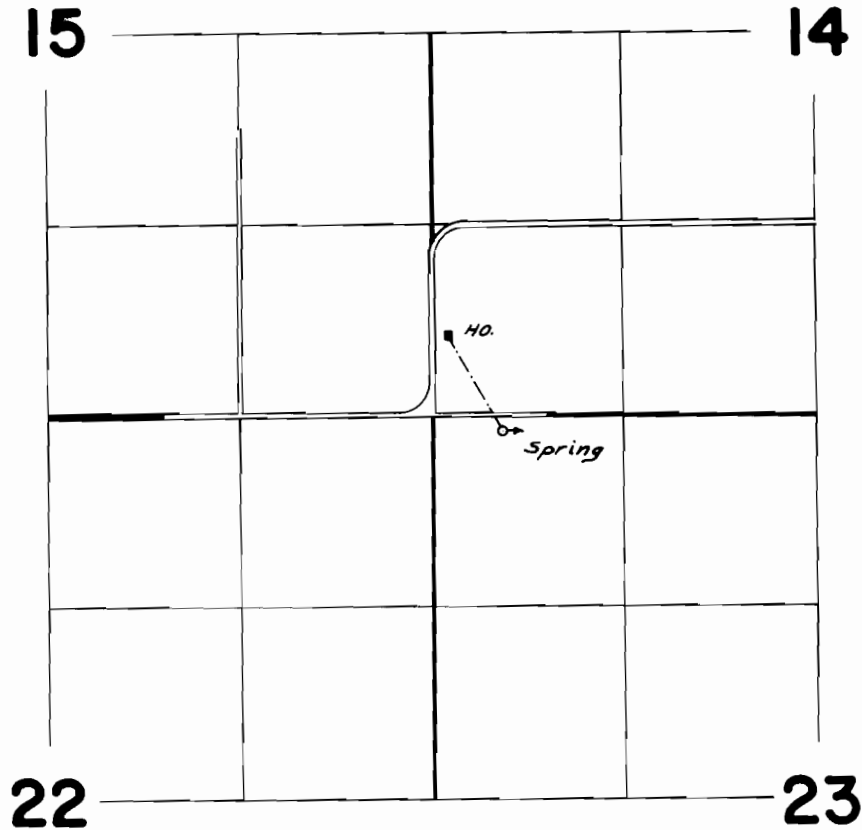

Spring Loc.: 90'S., & 510'E. from NW Cor. Sec. 23

FINAL PROOF SURVEY
UNDER

Application No. 50139 Permit No. 37672
IN NAME OF

Dean & Estella Puckett

Surveyed Sept. 23, 1976, by D. M. Norby