


T. 3S., R. 40E., W.M.

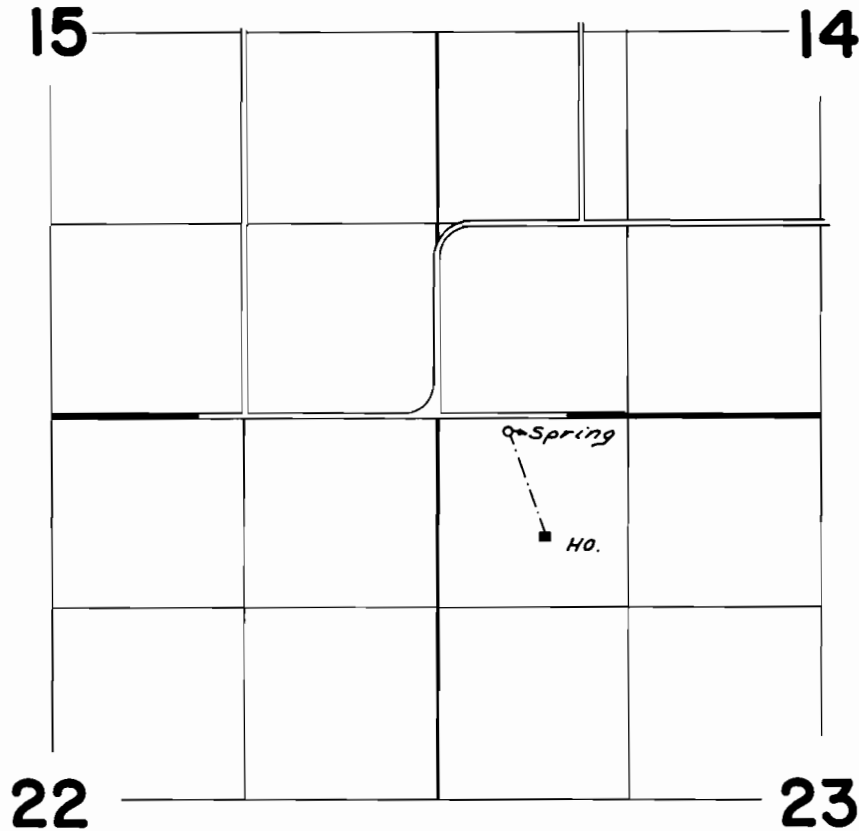

Spring Loc.: 90'S. & 510'E. from NW cor. Sec 23

FINAL PROOF SURVEY UNDER

Application No. 50158 Permit No. 37680
IN NAME OF

T. A. & G. M. Morton

Surveyed Sept. 23, 1976, by D. M. Norby