


# T. 3 S., R. 39 E., W.M.

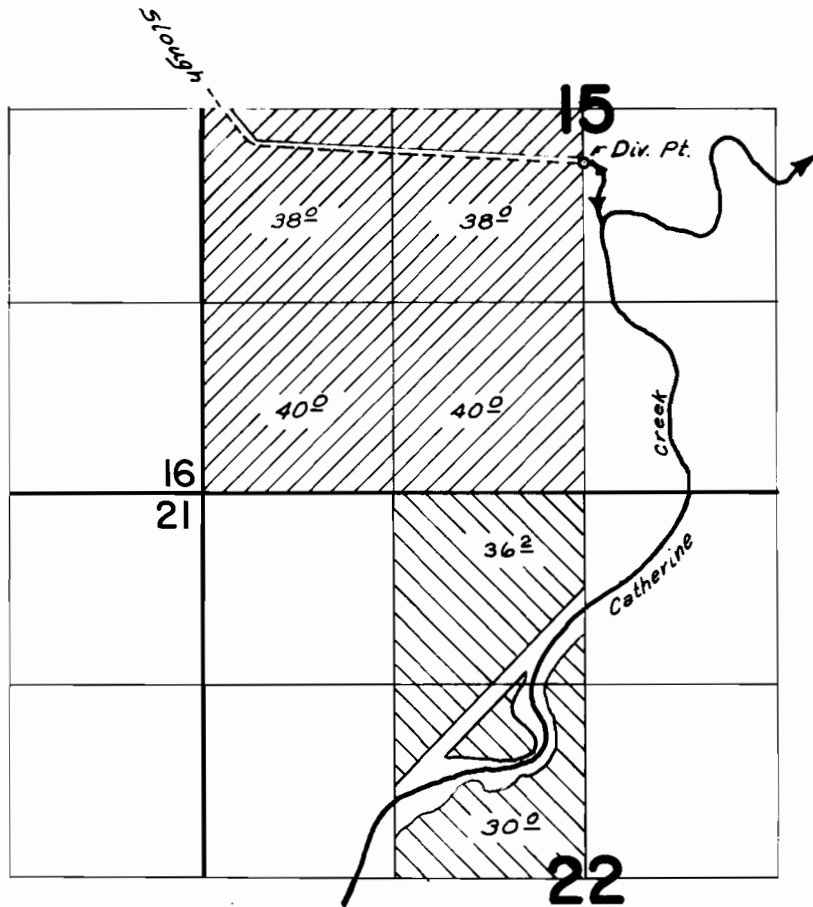

Div. Pt. Loc.: 360' S. from ctr. Sec. 15

## FINAL PROOF SURVEY UNDER

Application No. 50832 Permit No. 38379  
IN NAME OF

James R. Scott

Surveyed Sept 25, 1976, by D.M. Norby