


T.2S. R.40E. W.M.

**RECEIVED**  
 JAN 21 1975  
 STATE ENGINEER  
 SALEM, OREGON

Application No. R-52725 + 52726  
 Permit No. R 6363 & 39612

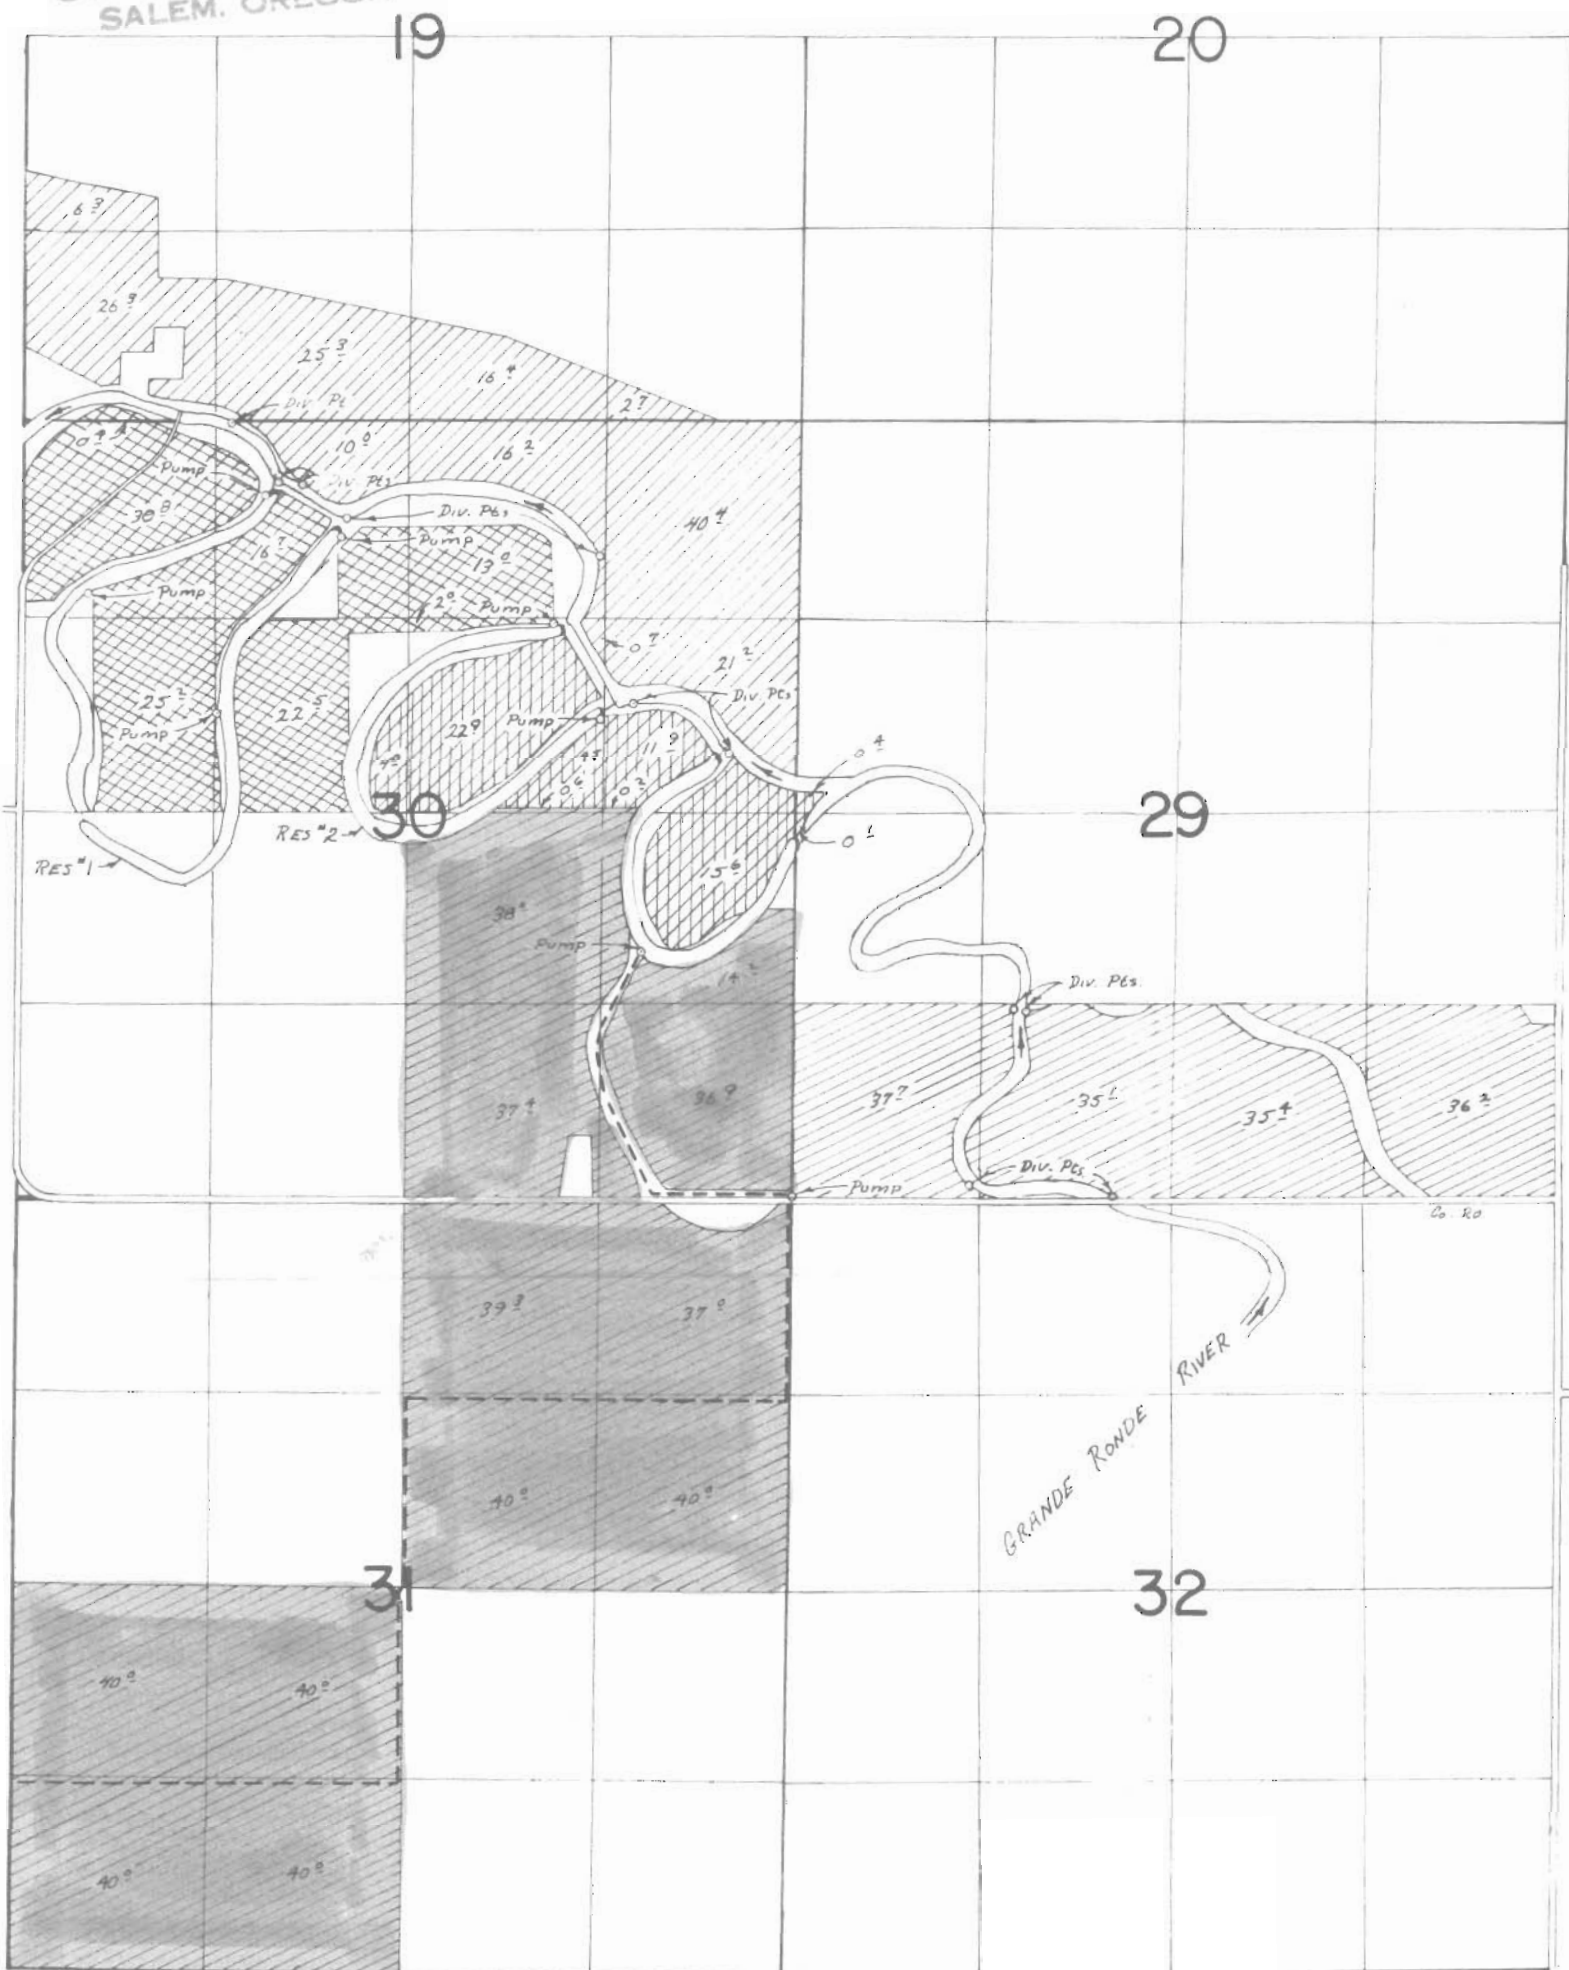

Div. Pcs. Loc. : \*1-5270' N \* 3900' W ; \*2-4890' N \* 3570' W ; \*3-4860' N \* 3420' W ; \*4-4640' N \* 3110' W ; \*5-4400' N \* 1960' W ; \*6-3400' N \* 1130' W ; \*7-3050' N \* 470' W ; \*8-1300' N \* 1500' E ; \*9-1280' N \* 1600' E ; \*10-120' N \* 1200' E ; \*11-60' N \* 2200' E  
 RES. LOC. : RES #1-4940' N \* 3630' W ; RES #2-3890' N \* 1260' W ;  
 ALL FROM SE COR. SEC. 30 T.2S. R.40E. W.M.

- |   |                            |   |                      |
|---|----------------------------|---|----------------------|
|   | Primary River Permit 28798 |  | SUPPLEMENTAL RES # 1 |
|   | Primary River Permit 30036 |  | SUPPLEMENTAL RES # 2 |
|  | Supplemental from Res #3   |   |                      |

**FINAL PROOF SURVEY**  
 UNDER

Application No. 37688 28798  
 R-38492 R-4502  
 R-38493 R-4503  
 Application No. 38495 Permit No. 30036

IN NAME OF  
 RUSSELL ELMER

Surveyed July 18, 1973, by ROBERT G. MUCKEN