


T.2S. R.40E. W.M.

RECEIVED
JAN 21 1975
STATE ENGINEER
SALEM, OREGON

Application No. R-52725 + 52726
Permit No. R 6363 & 39612

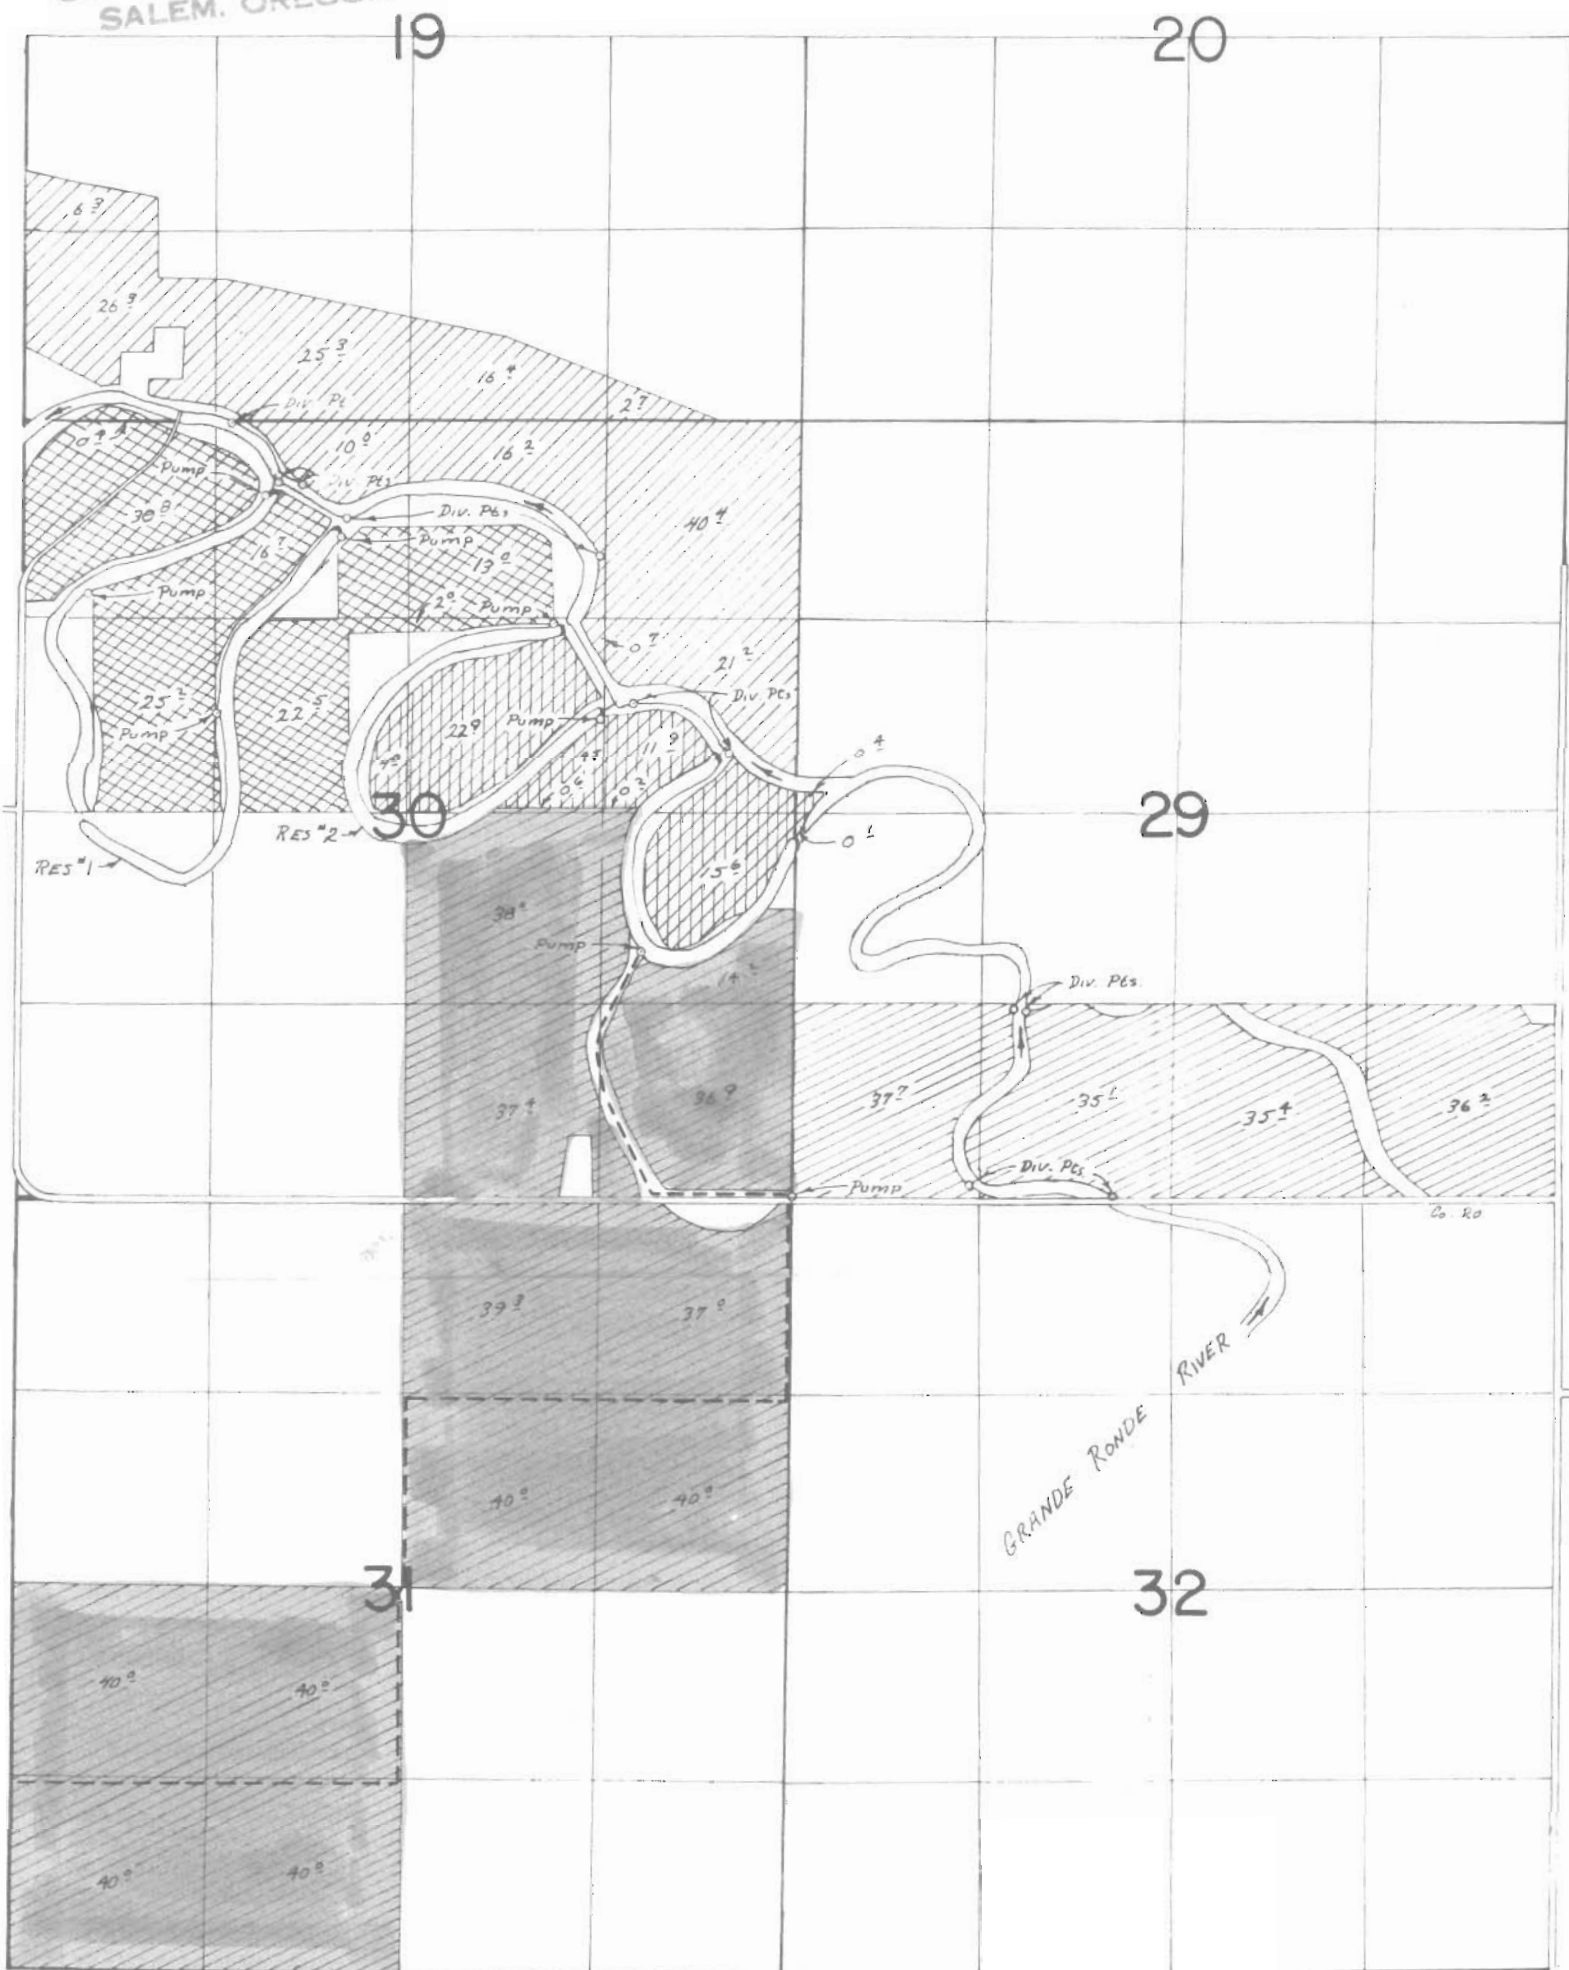

Div. Pts. Loc. : *1-5270' N * 3900' W ; *2-4890' N * 3570' W ; *3-4860' N * 3420' W ; *4-4640' N * 3110' W ; *5-4400' N * 1960' W ; *6-3400' N * 1130' W ; *7-3050' N * 470' W ; *8-1300' N * 1500' E ; *9-1280' N * 1600' E ; *10-120' N * 1200' E ; *11-60' N * 2200' E

RES. LOC. : RES #1-4940' N * 3630' W ; RES #2-3890' N * 1260' W ;
ALL FROM SE COR. SEC. 30 T.2S. R.40E. W.M.

 Primary River Permit 28798
 Primary River Permit 30036

 SUPPLEMENTAL RES # 1
 Supplemental Res # 2

 Supplemental from Res #3

FINAL PROOF SURVEY

UNDER

37688
R-38492
R-38493

28798
R-4502
R-4503

Application No. 38495 Permit No. 30036

IN NAME OF

RUSSELL ELMER

Surveyed July 18, 1973, by ROBERT G. MUCKEN