


T. 2 S., R. 38 E., W. M.

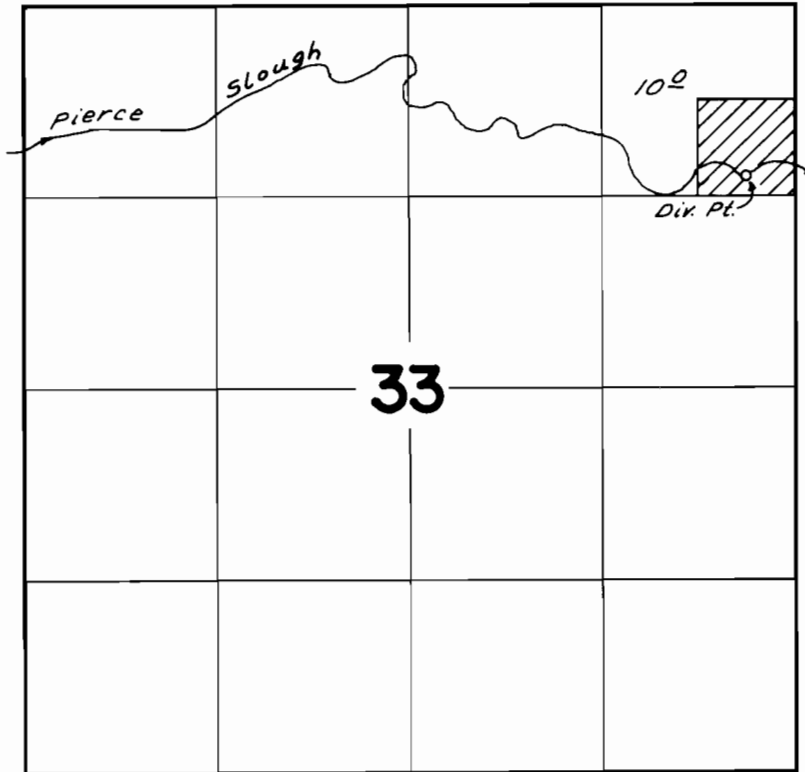

Dir. Pt. Loc.: 1190 'S., 340 'W. from NE Cor. Sec 33

**FINAL PROOF SURVEY**  
UNDER

Application No. 53696 Permit No. 40144  
IN NAME OF

Thurston Dwain Spooner

Surveyed Sept. 25, 1976, by D. M. Norby