


T. 4 S. R. 11 E. W. M.

*7-6-78
Superintendent
can find record with plat 34734
9755*

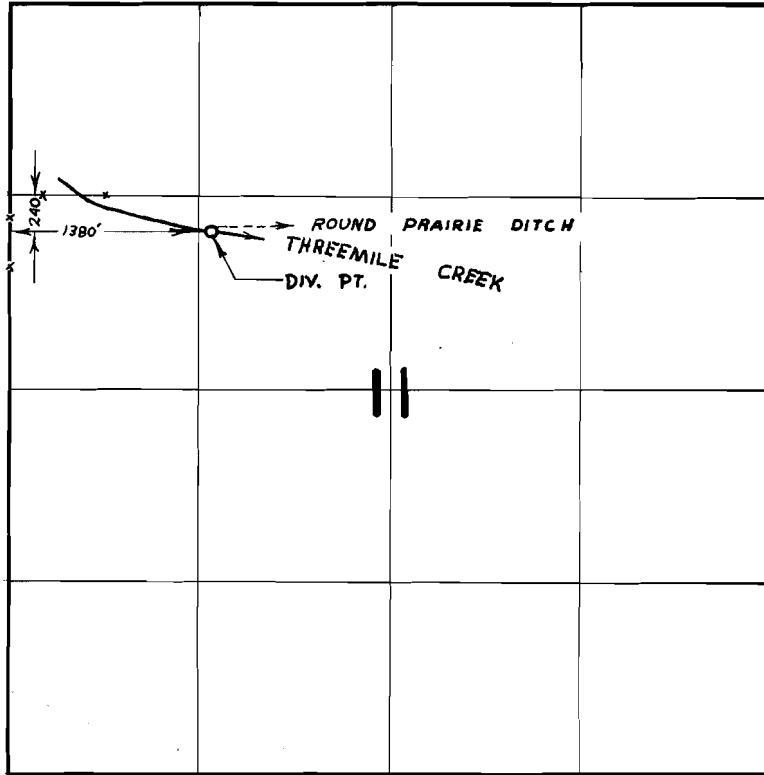

FINAL PROOF SURVEY UNDER

Application No. 40389 Permit No. 30206
IN NAME OF

ROUND PRAIRIE WATER DITCH COMPANY

Surveyed NOV. 12, 1971, by R. MUCKEN