


T. 4 S. R. 12 E. W.M.

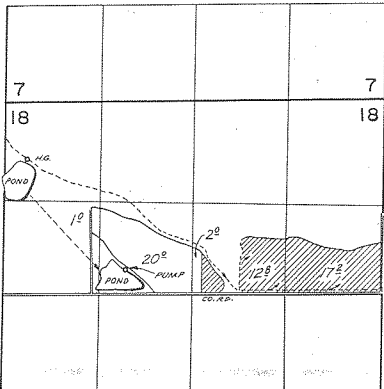

Q1/4 PT. FROM THREEMILE CREEK; 724' S. & 528' W. FROM N.E. COR. SEC. 10, T. 4 S. R. 12 E.

FINAL PROOF SURVEY UNDER

TRANSFER No. 0-49
Application No. _____ Permit No. _____
IN NAME OF

Department of Fish & Wildlife

Surveyed JUNE 4 1975 by R.G. MUCKEN