


T.4S.R.4E. W.M.

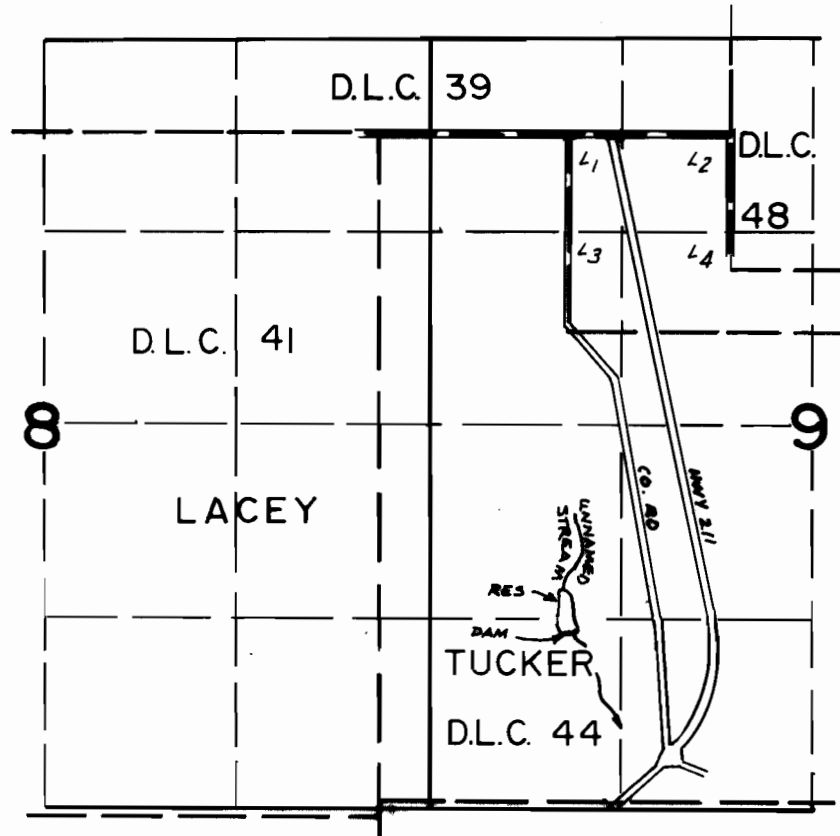

DAM LOCATED: 1236' NORTH & 1260' EAST FROM SE COR LACEY DLC 41

FINAL PROOF SURVEY
UNDER

R54376

R 6497

Application No. 54377 Permit No. 40693
IN NAME OF

W.K. LONDON

Surveyed AUG. 19... 1977., by R. BARWIN.....