


T.28S., R.4W., W.M.

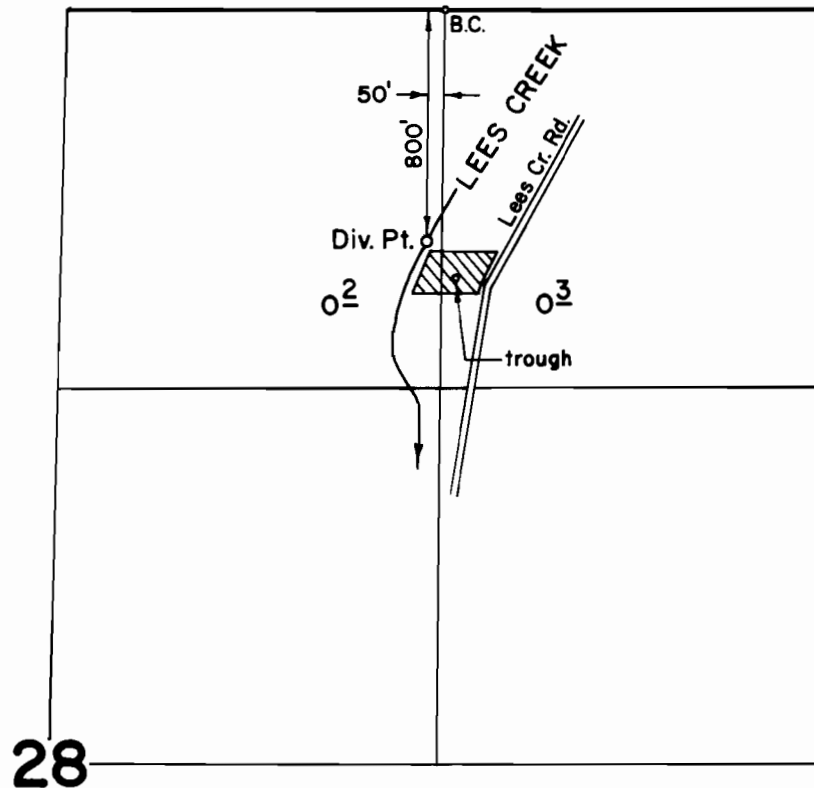

Scale: 1" = 660'

FINAL PROOF SURVEY
UNDER

Application No. 50178 Permit No. 37919
IN NAME OF

STANLEY G. CHURCH

Surveyed Oct. 15 1976, by D. Norby